

# Bill as Introduced

HJR 1 - AS INTRODUCED

2011 SESSION

11-0391  
06/05

HOUSE JOINT RESOLUTION *1*

A RESOLUTION directing the department of transportation and the department of environmental services to study the prevention of further erosion of the east bank of the Exeter River.

SPONSORS: Rep. Itse, Rock 9; Rep. Comerford, Rock 9; Rep. Antosz, Rock 9; Sen. Barnes, Jr., Dist 17

COMMITTEE: Resources, Recreation and Development

---

ANALYSIS

This joint resolution directs the department of transportation and the department of environmental services to study the prevention of further erosion of the east bank of the Exeter River.

HJR 1 - AS INTRODUCED

11-0391  
06/05

STATE OF NEW HAMPSHIRE

*In the Year of Our Lord Two Thousand Eleven*

A RESOLUTION directing the department of transportation and the department of environmental services to study the prevention of further erosion of the east bank of the Exeter River.

*Be it Enacted by the Senate and House of Representatives in General Court convened:*

1       Whereas, the replacement of bridge 096095 in 1998 changed the course of the Exeter River  
2 immediately downstream of the bridge; and

3       Whereas, the change in the course of the river causes the river to erode the east bank during  
4 floods; and

5       Whereas, such erosion threatens the property on the east river bank, including the Liberty Market  
6 located at the intersection of New Hampshire Route 107 and Sandown Road in Freemont; and

7       Whereas, the substantial changes to the river include the width of the channel, the roughness of  
8 the walls, and the removal of the center support which was angled so as to direct water away from  
9 the east bank of the river; now, therefore, be it

10       Resolved by the Senate and House of Representatives in General Court convened:

11       That the general court of the state of New Hampshire hereby directs the department of  
12 transportation and the department of environmental services to perform a study to determine the  
13 least costly method to prevent further erosion of the east bank of the Exeter River downstream of  
14 bridge 096095 and prepare all necessary permit applications to affect said further erosion.

# Speakers





# Hearing Minutes

HOUSE COMMITTEE ON RESOURCES, RECREATION AND DEVELOPMENT

PUBLIC HEARING ON HJR 1

**BILL TITLE:** directing the department of transportation and the department of environmental services to study the prevention of further erosion of the east bank of the Exeter River.

**DATE:** January 25, 2011

**LOB ROOM:** 305      **Time Public Hearing Called to Order:** 1:30 p.m.

**Time Adjourned:** 2:00 p.m.

(please circle if present)

**Committee Members:** Reps. Renzullo, Kappler, C. Christensen, Russell, Ahlgren, Merrow, Bolster, Howard, Hutchinson, Lovett, Pettengill, Schroadter, Spang, Parkhurst, Moody, Aguiar and Thomas.

**Bill Sponsors:** Rep. Itse, Rock 9; Rep. Comerford, Rock 9; Rep. antosz, Rock 9; Sen. Barnes, Jr., Dist 17

TESTIMONY

\* Use asterisk if written testimony and/or amendments are submitted.

**Rep. Chris Ahlgren** - Introduced the bill. No sponsor available.

**Nancy Mayville, NH Department of Transportation (DOT)** - Opposes the bill. Oversees funding to Towns for town projects such as bridge replacements. This was a town managed project. Town gets reimbursed 80% when job is done. This project had no pier replacement. Flow is unchanged. DOT is opposed to further study. Town owns the bridge; any problems are the town's to resolve. Construction was in 1998. Erosion is downstream of the bridge, not in the area of the construction.

**Rene Pelletier with Steve Couture, NH Department of Environmental Services (DES)** - Opposes the bill. DES and FEMA contributed to a study done by Beer Creek Environment. Conclusion - "there might be some alignment issues". Rip rap and bank erosion may have contributed. Design criteria was met. Municipality needs to talk to their consultant. DES has no funding for this bill/study. The town has not contacted DES on this matter.

Respectfully submitted



Rep. D. L. Chris Christensen  
Clerk



HOUSE COMMITTEE ON RESOURCES, RECREATION AND DEVELOPMENT

PUBLIC HEARING ON HJR 1

**BILL TITLE:** directing the department of transportation and the department of environmental services to study the prevention of further erosion of the east bank of the Exeter River.

**DATE:** 1/25/11

**LOB ROOM:** 305

**Time Public Hearing Called to Order:** 1:30 p.m.

**Time Adjourned:** ~~1:45 p.m.~~ 2 PM  
(~~1:45 p.m.~~)

(please circle if present)

**Committee Members:** Reps. Renzulla, Kapple, C. Christensen, Russell Ahlgren, Morrow, Bolster, Howard, Hutchinson, Lovett, Pettengill, Schroadter, Spang, Parkhurst, Moody, Aguiar and Thomas.

**Bill Sponsors:** Rep. Itse, Rock 9; Rep. Comerford, Rock 9; Rep. antosz, Rock 9; Sen. Barnes, Jr., Dist 17

TESTIMONY

\* Use asterisk if written testimony and/or amendments are submitted.

4/25/11

19 1 2 2

1) HJR-1

Rep. Ahlgrun - Intro. No sponsors available.

~~Chair - Rep Kappeler - received hearing.~~

2) Nancy Mayville - D.O.T. OPPOSE.

Oversees funding to Towns for town projects such as bridge replacements. - This was a town managed project Town gets reimbursed 80% when job is done. This project had no pier replacement of flow is unchanged.

DOT is opposed to further study. Town owns the bridge; any problems are the Town's to resolve. Construction was in 1998.

1/25/11

~~AB~~ HJCI -

P, 2 of 2

cont.

Mayville

Erosion is downstream of the bridge, not in the area of the construction

3) Rene Pelletier - DES - OPPOSE -  
w/ Steve Cantore.

DES & FEMA contributed \$ for a study done by Bear Creek Environmental.

Conclusion: "There might be some alignment issues" Rip rap & bank armoring may have contributed. Design criteria was met. Municipality needs to talk to their consultant.

DES has no funding for this bill/study

The Town has not contacted DES on this matter.

HOUSE COMMITTEE ON RESOURCES, RECREATION AND DEVELOPMENT

PUBLIC HEARING ON HJR 1 Continued

**BILL TITLE:** directing the department of transportation and the department of environmental services to study the prevention of further erosion of the east bank of the Exeter River.

**DATE:** February 1, 2011

**LOB ROOM:** 305      **Time Public Hearing Called to Order:** 11:15 a.m.

**Time Adjourned:** 12:16 p.m.

(please circle if present)

**Committee Members:** Reps. Renzullo, Kapple, C. Christensen, Russel, Ahlgren, Morrow, Golster, Howard, Hutchinson, Lovett, Pettengill, Schroadter, Spang, Parkhurst, Moody, Aguiar and Thomas

**Bill Sponsors:** Rep. Itse, Rock 9; Rep. Comerford, Rock 9; Rep. Antosz, Rock 9; Sen. Barnes, Jr., Dist 17

TESTIMONY

\* Use asterisk if written testimony and/or amendments are submitted.

**Rep. Dan Itse** - Prime sponsor of the bill. Supports the bill. 1996 we had a 50 year flood, damaging abutment on West Side of river. In replacing the bridge, the water damage shifted. The center of the bridge had a pier that also shifted threatening the old general store. Rep. Itse claims when the bridge was rebuilt, the design was flawed, causing further erosion. Prior to the flood, the flow was on the other side. Store has been there 100 years, the expansion is 30 years old. The Town of Fremont has not contacted either the Department of Environmental Services (DES) or the Department of Transportation (DOT). Are the engineers who redesigned the bridge responsible?

\* **Nancy Mayville, NH Department of Transportation** - Opposes the bill. Reviewed old files and supplied three letters from files. Town owns the bridge and DOT reviewed plans for compliance with national standards and it meets standards. The original engineering firm has changed but the Town of Fremont could still go back to that firm or the designing engineers. Adding back a replacement bridge center support, which under new construction is not necessary, would not solve the erosion problem. Landowner should install shore stabilization. Designing engineer has continuing responsibility but Ms. Mayville does not know how many years that lasts.

Question: Rep. Bolster for Rene Pelletier of DES – Large increases in water volume and velocity has created problems that did not exist 10 years ago. Other development in the last 10-15 years changes things like impervious surface and affects streams all over the state. We lost 45 feet of land on the Mohawk River in the last two years. Adding a fix e.g. rip-rap in place forces water flow to cause a problem elsewhere. DES agrees with DOT that it is the town's problem. Growth has changed the character of flood plain. FEMA will be redrawing flood maps.

Respectfully submitted,

A handwritten signature in black ink, appearing to read "Chris Christensen". The signature is written in a cursive style with a large, sweeping flourish at the end.

Rep. D. L. Chris Christensen  
Clerk

HOUSE COMMITTEE ON RESOURCES, RECREATION AND DEVELOPMENT

PUBLIC HEARING ON HJR 1 Continued

**BILL TITLE:** directing the department of transportation and the department of environmental services to study the prevention of further erosion of the east bank of the Exeter River.

**DATE:** February 1, 2011

**LOB ROOM:** 305      **Time Public Hearing Called to Order:** 11:15 a.m.

**Time Adjourned:** 12:16 pm

(please circle if present)

**Committee Members:** Reps. Renzullo, Kappler, C. Christensen, Russell, Ahlgren, Morrow, Bolster, Howard, Hutchinson, Kovett, Pettengill, Schroadter, Spang, Parkhurst, Moody, Aguiar and Thomas.

**Bill Sponsors:** Rep. Itse, Rock 9; Rep. Comerford, Rock 9; Rep. Antosz, Rock 9; Sen. Barnes, Jr., Dist 17

TESTIMONY

\* Use asterisk if written testimony and/or amendments are submitted.

2/11/11 HJR 1 Re-opened. pg 1 of 3

Continued Public Hearing HJR 1 2/11/11

① Rep. Dan Itse, Prime Sponsor (Supports)

1996 we had a 60 yr flood, damaging abutment on West Side of River. In replacing the bridge, the water damage shifted. The center of the bridge had a pier that also shifted. Threatening the old general store. Rep Itse claims when the bridge was rebuilt, the design was flawed, causing further erosion. Prior to the flood, the flaw was on the other side. Store has been there 100 years, the expansion is 30 years old. Fremont has not contacted either DES or DOT. Are the engineers who re-designed the bridge responsible?

2) Nancy May with NH DOT reviewed old files & supplied 3 letters from files.

Town owns the bridge & DOT reviewed plans for compliance with national standards & it meets standards.

pg 2 of 3

The original engineering firm has changed but the Town of Fremont could still go back to that firm or the designing engineer.

Adding back a replacement bridge center support, which under new construction is not necessary would not solve the erosion problem. Landowner should install shore stabilization.

Designing engineer has continuing responsibility but Mr. Mayville does not know how many years that lasts.

→ Q - Belter for Rene Pelletier of DES - Large increases in water volume & velocity has created problems that did not exist 10 years ago. © the development




PT 3 of 3

in the last 10-15 years change things like impervious surface & affects streams all over the state. We lost 45 feet of bank on the Mohawk River in the last two years. Adding a rip rap, in one place forces water flows to cause a problem elsewhere.

DES agrees with DOT that it is the Town's problem.

Growth has changed the character of flood plains. FEMA will be re-drawing flood maps.

# Testimony

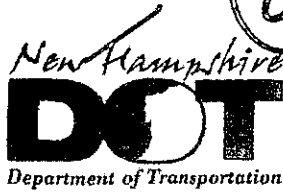

THE STATE OF NEW HAMPSHIRE  
DEPARTMENT OF TRANSPORTATION



GEORGE N. CAMPBELL, JR.  
COMMISSIONER

JEFF BRILLHART, P.E.  
ASSISTANT COMMISSIONER  
March 23, 2009

The Honorable Candace White Bouchard  
N.H. House of Representatives  
71 Northeast Village Road  
Concord, N.H. 03301

Dear Representative Bouchard:

I am writing in response to your request for information regarding a bridge carrying Sandown Road over the Exeter River in Fremont. The bridge is owned by the Town of Fremont and was replaced by the Town using the State Aid Bridge program in 1998. An abutter feels the replacement of this bridge changed the flow of the river creating erosion problems along the rivers bank.

The Department manages the State Aid Bridge program in accordance with State law as a benefit to municipalities dealing with local bridge improvements. The actual design and construction for the bridge was managed by the Town of Fremont, and any outstanding issues relative to the bridge are the responsibility of the Town. I believe the property owner should contact the Town with his concerns.

Hopefully this information is helpful. If you have questions or comments, please call.

Sincerely,

David J. Brillhart, P.E.  
Assistant Commissioner

DJB:d


cc: George Campbell  
Nancy Mayville

~~NEED ORIGINAL LETTER FROM  
THAT PROMPTED THIS LETTER.~~  
attached

RECEIVED  
DEPARTMENT OF  
TRANSPORTATION

MAR 25 2009

Division of  
Planning and Community Assistance

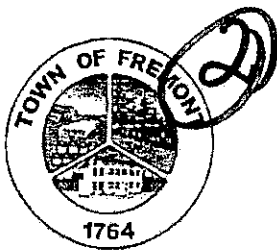

## Town of Fremont ~ New Hampshire

Office of the Selectmen  
Telephone 603 895 2226  
Facsimile 603 895 3149

295 Main Street  
PO Box 120  
Fremont NH 03044-0120

RECEIVED  
COMMISSIONERS OFFICE

09 July 2009

JUL 21 2009

Representative Dan Itse  
20 Kelsey Drive  
Fremont NH 03044

THE STATE OF NEW HAMPSHIRE  
DEPT. OF TRANSPORTATION

COPY

Sandown Road over Exeter River  
Bridge 096/095

Dear Dan:

We are in receipt of your email dated June 8, 2009 and associated documents. We reviewed same at a recent meeting.

We find it unfortunate that no one has thought until now, to bring this matter to the attention of the Board of Selectmen. We understand that some years ago, Mr Arnofsky mentioned concerns about the store's foundation issues to the Town Administrator while she was making a purchase in the store, at which time she encouraged him to make contact with the Board. We have never heard from him in this regard.

As you may know, the Town spent a great deal of time and money on the reconstruction project for the formerly red-listed bridge that carries Sandown Road over the Exeter River. The reconstruction was engineered to State specifications, approved and 80% reimbursement funded, by the NH Bridge Aid Program.

The Town did some additional hand mortar and concrete work at the edge of their parking lot after reconstruction of the bridge. We do not know if this was caused from parking lot drainage, but did the work in an effort to alleviate future problems in that area.

You may also know that the property currently known as Liberty Square Market sits on a very small lot (1/2 acre); and that the building takes up virtually all of the space on that lot. The building has always been extremely close to the river bank. In the past 10 years since the bridge replacement, we have had 3 virtually-500-year floods, which are no reflection on the Town or the property, but exigent circumstances of nature. It may also be assumed that the several floods which occurred in the late 1980's and through the 1990's also contributed to the erosion issues in this lot.

Additionally, the additions put on to the building 25 to 30 years ago would never be allowed now, as they are far too close to the river. The added-on buildings brought it closer to the river and may also have to do with the accumulated problems in terms of weight and sprawl.


Rep Dan Itse  
Page Two  
09 July 2009

While the Board finds it unfortunate that any property owner has to do repairs to their property, we do not believe that this matter could be blamed on the State of NH or the Town of Fremont. Each followed the respective planning, engineering, permitting, and construction as outlined by state laws, and the bridge has worked well in the 10 years since its completion. There are a variety of mitigating factors in the history of the site as well.

We wish you luck in your endeavor, and would offer the Town's support in as much as we could reasonably accommodate.

Sincerely yours,

The Fremont Board of Selectmen

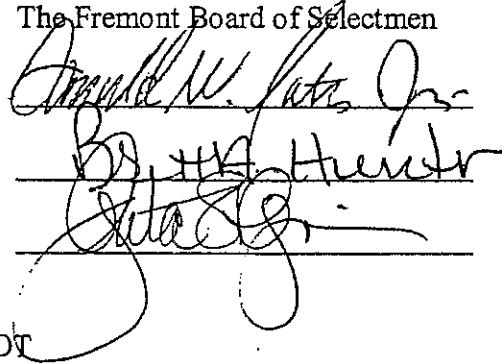

C: David Brillhard PE, Asst Commissioner NH DOT  
Barry & Sharen Arnofsky  
Rep Baldasara, Rock 3  
Rep Dumaine, Rock 3  
Rep Ingbretson, Grafton 5  
Guerwood Holmes, Road Agent

<input type="checkbox"/>	INFO
<input type="checkbox"/>	Administrative
<input type="checkbox"/>	Asst. Operations
<input type="checkbox"/>	Operations
<input type="checkbox"/>	Project Management
<input type="checkbox"/>	Public Information
<input type="checkbox"/>	Technical Support
<input type="checkbox"/>	Training
<input type="checkbox"/>	Other
<input type="checkbox"/>	RETURN TO:



2

THE STATE OF NEW HAMPSHIRE  
DEPARTMENT OF TRANSPORTATION

September 10, 1997

LEON S. KENISON  
COMMISSIONER

Heidi Carlson, Administrative Assistant  
Town of Fremont  
PO Box 120  
Fremont, NH 03044

**Re: Fremont Bridge Aid Project 12554**  
**Bridge Number 096/095**  
**Sandown Road over Exeter River**

Dear Ms. Carlson:

The set of final design plans submitted by BAC Killam for the subject project have been reviewed and the following comments are offered:

1. The end walls will make access to the post-tensioning strands extremely difficult in the future. Perhaps this won't be necessary, or maybe the post-tensioning ducts could be moved to  $2' \pm$  from centerline of bearing.
2. Where the voided slabs pass through the end walls there will be a  $4 \frac{1}{4}$ " gap (including 1" expansion material).
3. Detail of the backwall (Section A-A on Sheet 10 of 24) is awkward. We have attached a detail that we've used at the ends of voided slab bridges.

Subject to resolution of these comments with the final plans, we therefore give approval of the final plans and you may proceed with the bid phase of the project. Upon receipt of the bids please forward a copy of the bid tabulations for our review and concurrence to award. As soon as you provide a paid invoice for preliminary engineering services we will reimburse the Town for 80% of that cost.

Sincerely,

  
Robert T. Barry, Administrator  
Bureau of Municipal Highways

RTB/ds

cc: James A. Moore, Administrator, Bureau of Bridge Design  
Matthew Severson, BAC Killam

Bureau of Municipal Highways  
John O. Morton Building - Room 111  
Telephone: (603) 271-2107



PLANS C

BRIDGE RI

SAI


SANDOV

OVER

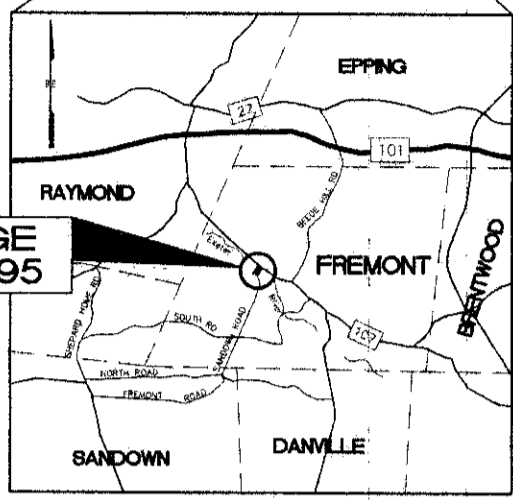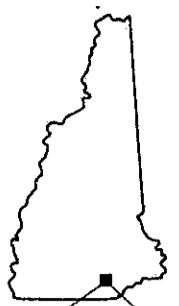

BRIDGE  
096/095

LOCATION MAP

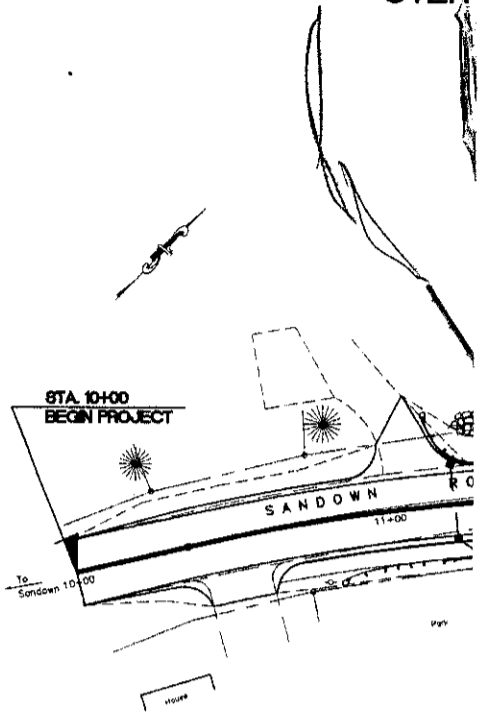

*Rob J  
Tom Marshall*

*Low Car en  
2' wall  
Sewer 150  
Manholes  
603 623 03011  
4400*


BRID

	PLANS PREPARED BY	
	<b>BAC Killam</b> THE CONCORD CENTER 10 FERRY STREET CONCORD, NEW HAMPSHIRE	

TOWN  
ROCKI

*SEA  
Consult*

OF PROPOSED  
 REPLACEMENT AND  
 FETY WORK  
 W ROAD BRIDGE  
 EXETER RIVER

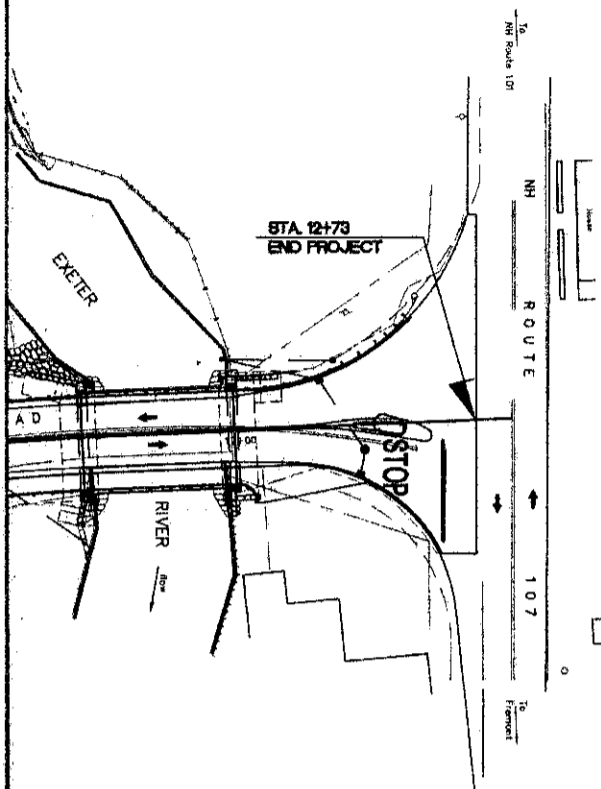

GE NO. 096/095  
 LAYOUT  
 SCALE: 1" = 30'

OF FREMONT  
 GHAM COUNTY

INDEX OF SHEETS

TITLE SHEET	1
INDEX OF STANDARD PLANS	2
TEMPORARY EROSION CONTROL DETAILS	3
SUMMARY OF QUANTITIES	4
GENERAL PLAN AND ELEVATION	5
BORING LOGS	6
BORING LOGS	7
ABUTMENT 1 MASONRY	8
ABUTMENT 1 REINFORCING	9
ABUTMENT 2 MASONRY	10
ABUTMENT 2 REINFORCING	11
DECK PLAN AND TRANSVERSE SECTION	12
PRESTRESSED CONCRETE BEAMS	13
PRESTRESSED CONCRETE BEAMS	14
PRESTRESSED CONCRETE BEAM DETAILS	15
BRIDGE RAIL DETAILS (3-BAR ALUMINUM)	16
APPROACH RAIL DETAILS (3-BAR ALUMINUM)	17
BRIDGE RAIL SPLICE BAR DETAILS (ALUMINUM)	18
ALUMINUM BALUSTER DETAILS	19
ROADWAY TYPICAL SECTION	20
ROADWAY PLAN AND PROFILE	21
CURBING, PAVEMENT AND PAINTING LAYOUT	22
ROAD CLOSURE / CONSTRUCTION TIES	22
CROSS-SECTIONS SANDOWN ROAD	23
WETLAND PERMIT PLAN FOR SANDOWN RD. BRIDGE	24

CONTRACTOR TO NOTE

- 1) THE CONTRACTOR SHALL COMPLETE ALL WORK NO LATER THAN OCTOBER 30, 1998.
- 2) SANDOWN ROAD SHALL BE CLOSED TO THROUGH TRAFFIC FROM MAY 11, 1998 THROUGH OCTOBER 5, 1998.
- 3) LIQUIDATED DAMAGES OF THREE HUNDRED DOLLARS (\$300.00) PER DAY, PLUS ENGINEERING CHARGES WILL BE ASSESSED FOR EACH CALENDAR DAY THAT THE ROADWAY REMAINS CLOSED AFTER OCTOBER 5, 1998.
- 4) LIQUIDATED DAMAGES OF THREE HUNDRED DOLLARS (\$300.00) PER DAY, PLUS ENGINEERING CHARGES WILL BE ASSESSED FOR EACH CALENDAR DAY THAT THE PROJECT IS NOT COMPLETE AFTER OCTOBER 30, 1998.

AS-BUILT PLANS  
 OCTOBER 31, 1998

STATE FILE NO.	STATE PROJECT NO.	SHEET NO.	TOTAL SHEETS
93-2-1	12544	1	24



# STANDARD PLANS

STANDARD NO. 1	CONCRETE AND M.R.M. HEADWALLS	REVISED	MARCH 24, 1977
STANDARD NO. 1A	CONCRETE AND M.R.M. HEADWALLS	REVISED	MAY 8, 1970
STANDARD NO. 2	STEEL ARCH PIPES, SLOPE PAVING, UNDERDRAIN HEADWALL	REVISED	MARCH 1, 1983
STANDARD NO. 2A	CORRUGATED ALUMINUM PIPE, PIPE ARCH, UNDERDRAIN FLUSHING BASIN	REVISED	DECEMBER 20, 1982
STANDARD NO. 3	CATCH BASINS, DROP INLETS	REVISED	OCTOBER 17, 1983
STANDARD NO. 3A	GRATES FOR C.B.'S & D.I.'S	REVISED	OCTOBER 17, 1983
STANDARD NO. 3B	CATCH BASINS, DROP INLETS, TRAP	REVISED	OCTOBER 17, 1983
STANDARD NO. 4	CURBING	REVISED	APRIL 21, 1982
STANDARD NO. 5	CONCRETE BOUND, STEPS	REVISED	NOVEMBER 1, 1984
STANDARD NO. 5A	GUTTERS, SLUICE, SLOPES, MUCK EXCAVATION	REVISED	FEBRUARY 26, 1975
STANDARD NO. GR-1	BEAM GUARDRAIL, STD. SECTION-WOOD POSTS & HARDWARE DETAILS	REVISED	MAY 1, 1995
STANDARD NO. GR-1A	BEAM GUARDRAIL, STD. SECTION-STEEL POSTS & HARDWARE DETAILS	REVISED	MAY 1, 1995
STANDARD NO. GR-2	BEAM GUARDRAIL, TERMINAL UNIT TYPE MELT	REVISED	MAY 1, 1995
STANDARD NO. GR-2A	BEAM GUARDRAIL, MELT HARDWARE DETAILS	REVISED	MAY 1, 1995
STANDARD NO. GR-2B	BEAM GUARDRAIL, MELT HARDWARE DETAILS	REVISED	MAY 1, 1995
STANDARD NO. GR-3	BEAM GUARDRAIL, TERMINAL UNIT TYPE G-2	REVISED	MAY 1, 1995
STANDARD NO. GR-4	PRECAST CONC. MEDIAN BARRIER 1070 mm F-SHAPE (DOUBLE-FACED)	REVISED	MAY 1, 1995
STANDARD NO. 9	WOVEN WIRE & CHAIN LINK FENCE	REVISED	AUGUST 2, 1977
STANDARD NO. 9A	STEEL WITNESS MARKER, STEEL SIGN POST, DELINEATOR POST	REVISED	MAY 15, 1985
STANDARD NO. 10		DELETED	
STANDARD NO. 10A		DELETED	
STANDARD NO. 11	END SECTIONS FOR PIPES	REVISED	MAY 21, 1975
STANDARD NO. 12	DELINEATORS FOR GUARDRAIL, MEDIAN BARRIERS	REVISED	MAY 15, 1985
STANDARD NO. 12A	DELINEATOR SPACING FOR RAMPS AND LOOPS	REVISED	MAY 15, 1985
STANDARD NO. 13		DELETED	
STANDARD NO. 14		DELETED	
STANDARD NO. 15		DELETED	
STANDARD NO. 16		DELETED	

THE FOLLOWING STANDARD PLANS WILL BE USED ON THIS PROJECT:

				3	3A	3B	4					GR-2	GR-2A	GR-2B	GR-3	GR-4		9A	11	12	
--	--	--	--	---	----	----	---	--	--	--	--	------	-------	-------	------	------	--	----	----	----	--

**AS-BUILT (OCTOBER 31, 1998)**

STATE OF NEW HAMPSHIRE

DEPARTMENT OF TRANSPORTATION • BUREAU HIGHWAY DESIGN

### INDEX OF STANDARD PLANS





BAC Killam  
THE CONCORD CENTER  
10 FERRY STREET  
CONCORD, NH 03301

FILE NUMBER

23-2-1


REVISION DATE	BAC PROJECT NO.	BAC CAD FILENAME	FEDERAL PROJECT NO.	STATE PROJECT NO.	SHEET NO.	TOTAL SHEETS
8/97	96071.00	INDEX.DWG	-	12544	2	24

FED. ROAD DIST. NO.	STATE	PROJ.	FISCAL YEAR	SHEET NO.	TOTAL SHEETS
1	N.H.				

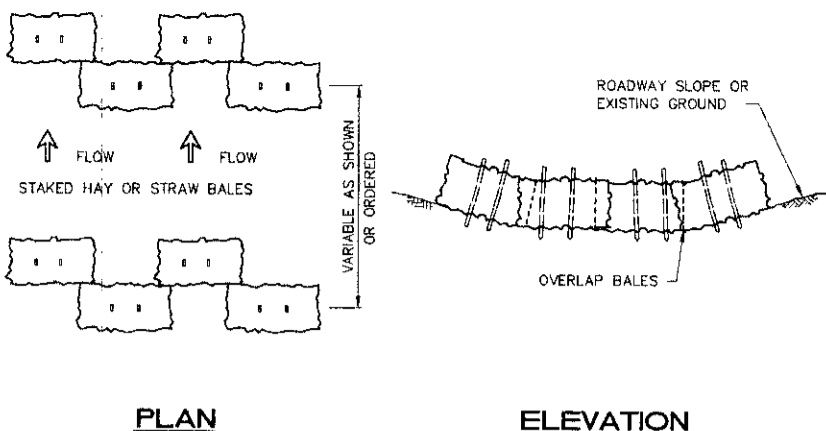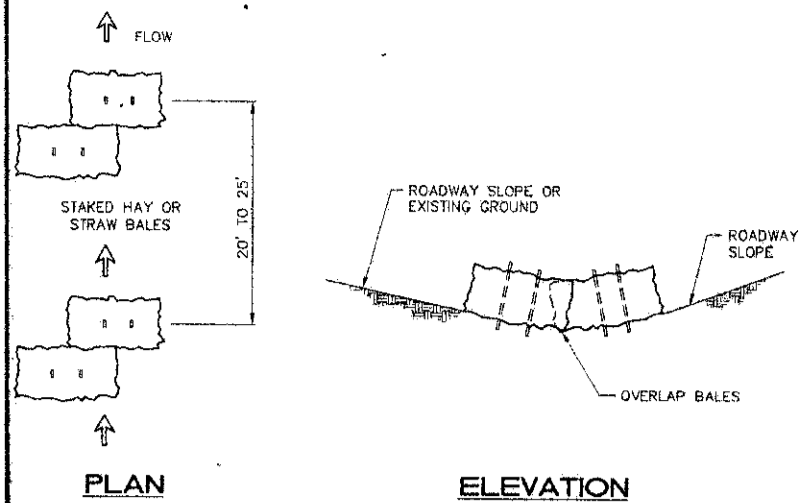

**EROSION PROTECTION TYPE C**  
NOT TO SCALE


**EROSION PROTECTION TYPE D**  
NOT TO SCALE

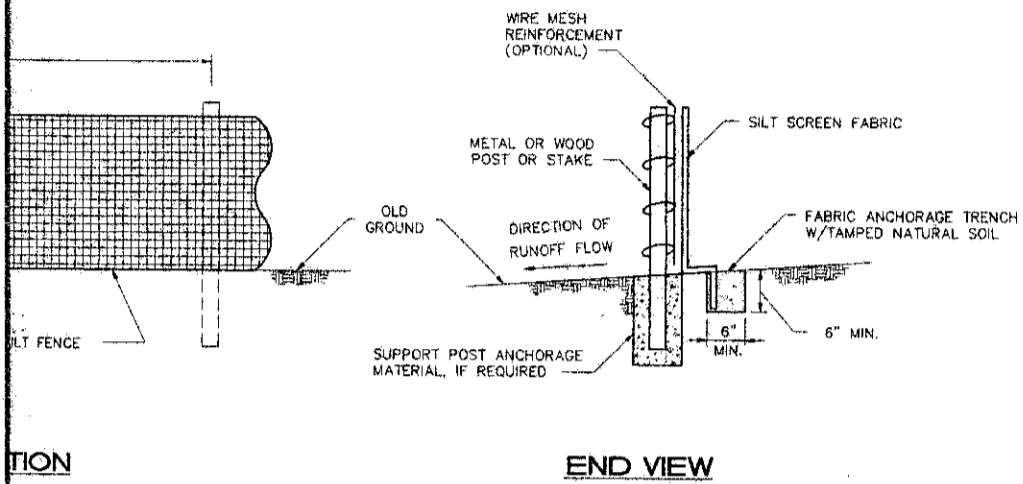

**GENERAL NOTES**

1. ALL WORK ASSOCIATED WITH TEMPORARY EROSION CONTROL, EXCEPT THAT DESCRIBED IN 699.5.2, WILL BE PAID FOR UNDER ITEM 699 - TEMPORARY PROJECT WATER POLLUTION CONTROL.
2. BALED HAY AND STRAW WILL BE SUBSIDIARY TO ITEM 699. STAKES TO HOLD BALES SHALL BE 2"x2" OR EQUIVALENT SAPPLINGS, AND SHALL BE LONG ENOUGH TO EXTEND 1 FOOT MINIMUM INTO THE GROUND. STAKES WILL BE SUBSIDIARY TO ITEM 699.
3. BALES SHALL BE SET 3 1/4" CHES ± BELOW THE GROUND SURFACE OR AS ORDERED. ANY REQUIRED EXCAVATION TO SET BALES WILL BE SUBSIDIARY.
4. HAY BALES WILL BE ALLOWED TO ROT IN PLACE EXCEPT IN HIGHLY VISIBLE AREAS WHERE THE ENGINEER MAY ORDER REMOVAL (SUBSIDIARY).
5. THE FENCE SHALL CONSIST OF POLYPROPYLENE FABRIC ATTACHED TO A WIRE MESH BACKING SECURED TO WOOD POSTS AS APPROVED BY THE ENGINEER.
6. POLYPROPYLENE FABRIC SHALL BE MIRAF 1100X OR APPROVED EQUAL.
7. WIRE MESH SHALL BE COMMON CHICKEN WIRE, HOG WIRE, OR AS OTHERWISE APPROVED BY THE ENGINEER.
8. SIX INCHES OF FABRIC SHALL BE TOED INTO THE GROUND BY DIGGING A TRENCH AND BACKFILLING OR BY LAYING THE EXCESS FABRIC ON THE GROUND AND PLACING FILL AT THE BASE.
9. PRIOR TO BEGINNING EARTHWORK OPERATIONS AT LOCATIONS DIRECTED BY THE ENGINEER, SILT FENCE SHALL BE CONSTRUCTED ALONG THE TOE OF PROPOSED EMBANKMENT SLOPES AT THE LIMITS OF CLEARING.
10. THE CONTRACTOR SHALL BE RESPONSIBLE FOR THE INTEGRITY OF THE SILT FENCE THROUGHOUT THE DURATION OF THE CONTRACT AND SHALL EFFECT REPAIRS AT HIS OWN EXPENSE. AT THE COMPLETION OF THE CONTRACT, THE FENCE SHALL BE REMOVED AND DISPOSED OF BY THE CONTRACTOR.


**SILT FENCE**  
NOT TO SCALE

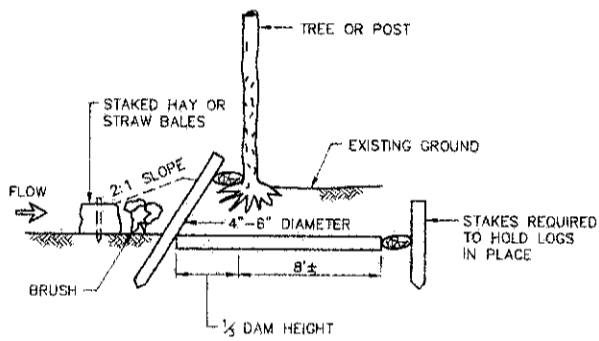

**SECTION B-B**

AS-BUILT (OCTOBER 31, 1998)

REVISION DATE	BAC PROJECT NO.	BAC CAD FILENAME	FEDERAL PROJECT NO.	STATE PROJECT NO.	SHEET NO.	TOTAL SHEETS
5-97	96071.00	T-EROS.DWG	-	12544	3	24

STATE OF NEW HAMPSHIRE			
DEPARTMENT OF TRANSPORTATION • BUREAU HIGHWAY DESIGN			
<b>TEMPORARY EROSION CONTROL DETAILS</b>			
 <b>BAC Killam</b> <small>THE CONCORD CENTER 10 FERRY STREET CONCORD, NH 03301</small>		FILE NUMBER <b>93-2-1</b>	

# SUMMARY OF QUANTITIES

THIS INFORMATION IS FOR BIDDING PURPOSES ONLY

ITEM NUMBER	DESCRIPTION	UNIT	QUANTITY
203.1	COMMON EXCAVATION	CY	200
203.5	BORROW	CY	50
209.201	GRANULAR BACKFILL BRIDGE (480 CY)	UNIT	1
214.	FINE GRADING	UNIT	1
304.3	CRUSHED GRAVEL	CY	200
304.35	CRUSHED GRAVEL FOR DRIVES	CY	5
403.11	HOT BITUMINOUS PAVEMENT - MACHINE METHOD	TON	150
403.12	HOT BITUMINOUS PAVEMENT - HAND METHOD	TON	20
403.911	HOT BITUMINOUS BRIDGE PAVEMENT - 1" BASE COURSE WITH POLYESTER FIBER	TON	10
502.101	REMOVAL OF EXISTING BRIDGE STRUCTURE	UNIT	1
503.1	WATER DIVERSION STRUCTURES	UNIT	1
504.1	COMMON BRIDGE EXCAVATION	CY	350
504.2	ROCK BRIDGE EXCAVATION	CY	350
508.	STRUCTURAL FILL	CY	70
520.01	CONCRETE - CLASS AA	CY	20
520.12	CONCRETE - CLASS A, ABOVE FOOTINGS	CY	120
520.21	CONCRETE - CLASS B, FOOTINGS	CY	120
520.85	CONCRETE - BRIDGE DECK OVERLAY INCL. HIGH RANGE WATER REDUCING ADMIXTURE	CY	17
529.1	PRESTRESSED CONCRETE BRIDGE DECK	UNIT	1
534.3	WATER REPELLENT (SILANE-SILOXANE)	GAL	6
538.2	BARRIER MEMBRANE - VERTICAL SURFACES	SY	38
538.4	BARRIER MEMBRANE - RUBBERIZED ASPHALT	SY	120
544.	REINFORCING STEEL	LB	17000
544.2	REINFORCING - EPOXY COATED	LB	2500
548.11	ELASTOMERIC BEARING PADS (16 EACH)	UNIT	1
563.73	BRIDGE RAIL F, 3-BAR ALUMINUM WITH BALUSTERS	LF	100
565.73	BRIDGE APPROACH RAIL F, 3-BAR ALUMINUM	LF	112
570.3	DRY SQUARED STONE MASONRY	CY	105
586.2	PLACING EXCAVATED ROCK FOR CHANNEL PROTECTION	CY	65
593.2	GEOTEXTILE, NON-WOVEN	SY	100
603.00215	15" R.C. PIPE, 2000D, INCLUDING SPECIFIED EXCAVATION	LF	120
604.12	CATCH BASIN - TYPE B	UNIT	4
606.1451	BEAM GUARDRAIL (TERMINAL UNIT TYPE (MELT)) GR-1451	UNIT	2
606.147	BEAM GUARDRAIL (TERMINAL UNIT TYPE G-2) GR-147	UNIT	1
606.417	PORTABLE CONCRETE BARRIER FOR TRAFFIC CONTROL	LF	150
608.12	2" BITUMINOUS SIDEWALK	SY	10
609.01	STRAIGHT GRANITE CURB	LF	8
609.21	STRAIGHT GRANITE SLOPE CURB	LF	30
609.22	STRAIGHT GRANITE SLOPE CURB WITH RADIAL JOINTS	LF	50
609.3	STRAIGHT GRANITE CURB (BRIDGE)	LF	96
609.811	BITUMINOUS CURB - TYPE B (4" REVEAL)	LF	200
615.034	RELOCATING TRAFFIC SIGN - TYPE C	EACH	3
619.2	CONSTRUCTION SIGNS AND WARNING DEVICES	UNIT	1
621.21	REFLECTORIZED BEAM GUARDRAIL DELINEATOR (WHITE)	EACH	4
628.2	SAWED BITUMINOUS PAVEMENT	LF	225
632.0104	RETROREFLECTIVE PAINT PAVEMENT MARKING - 4" LINE	LF	1200
632.0112	RETROREFLECTIVE PAINT PAVEMENT MARKING - 12" LINE	LF	32
632.02	RETROREFLECTIVE PAINT PAVEMENT MARKING - SYMBOL OR WORD	SF	22.9
645.51	HAY BALES FOR TEMPORARY EROSION CONTROL	UNIT	100
645.531	SILT FENCE	LF	250
645.7	EROSION AND SEDIMENT CONTROL STORMWATER MANAGEMENT PLAN	UNIT	1
646.31	TURF ESTABLISHMENT WITH MULCH AND TACKIFIERS	ACRE	0.2
670.086	MAILBOX POST ASSEMBLIES	EACH	2
692.	MOBILIZATION	UNIT	1
699.	TEMPORARY PROJECT WATER POLLUTION CONTROL	ALLOWANCE	\$5000
1002.	REPAIRS OR REPLACEMENTS AS NEEDED	ALLOWANCE	\$1000

PROVIDE AND SCHEDULE ON SHOP  
 FEEL AND THE NECESSARY  
 SECURELY IN PLACE AT THE CORRECT  
 THE FABRICATOR SHALL MINIMIZE

ENGINEER OF COMPLETION OF  
 W AT LEAST 24 HOURS BEFORE  
 THE ENGINEER TO INSPECT THE

ROOM FINISH.

A SMOOTH, STEEL TROWELED

SHALL BE CONSTRUCTED FROM  
 BRIDGE SUBSTRUCTURE. THE  
 STONES WITH THE CONTRACTOR TO  
 SERIAL FOR REUSE PRIOR TO

RELATIVELY SQUARE UNLESS  
 STONES SHALL BE PLACED TO  
 BE EXPOSED FACE.

EVE THE MINIMUM DESIRED  
 NS. THE FACE OF THE WALL SHALL  
 SLIGHT BATTER BACK (2:12 MAX.).  
 PATTERN UNLESS OTHERWISE

ING RELATIVELY UNIFORM STONE SIZES.  
 T THE BASE OF THE WALL.

WILL BE CONSTRUCTED BEHIND THE  
 NFLECTS WITH THE APPROACH RAIL

HE TOWN SHALL BE DISPOSED OF BY

DER DRY SQUARE STONE MASONRY

OUGH TRAFFIC DURING  
 ND PORTABLE CONCRETE BARRIERS  
 T THE EXISTING BRIDGE BEGINS.

E FOR THE INSTALLATION AND  
 ND CONSTRUCTION DETOUR. REFER  
 HER INFORMATION REGARDING THE  
 REQUIREMENTS.


N THROUGHOUT CONSTRUCTION.  
 C ACCESS TO THE PARKING LOT AND  
 TRACT.

INTAINED BY THE CONTRACTOR

ON SHOWN ON THE PLANS IS  
 THE ACCURACY OR COMPLETENESS  
 FOR IS SOLELY RESPONSIBLE FOR  
 ON SITE DURING CONSTRUCTION.

E PROPERTY OF ANY PUBLIC UTILITY  
 A PART OF THIS CONTRACT. THE  
 E OWNER IN THE PERFORMANCE OF

AS-BUILT (OCTOBER 31, 1998)

SUMMARY OF QUANTITIES					
TOWN		FREMONT		BRIDGE NO. 096/095	
LOCATION SANDOWN ROAD BRIDGE OVER EXETER RIVER					
DESIGNED	BY	DATE	CHECKED	BY	DATE
	MAS	4/97		JWP	5/97
DRAWN	BY	DATE	CHECKED	BY	DATE
	MIR	4/97		MAS	5/97
QUANTITIES			CHECKED		
REVISION DESCRIPTION		BY	DATE	FILE NUMBER	
△				93-2-1	
BA&C Project No. 96071.00		BA&C CAD File	NTS-QUAN.DWG	BRIDGE SHEET NO.	
 <b>BAC Kilam</b> <small>THE CONCORD CENTER                  110 FERRY STREET                  CONCORD, NH 03301</small>		STATE FILE NO.		STATE PROJECT NO.	SHEET NO.
				12544	4
				TOTAL SHEETS	
				24	

**GENERAL NOTES**

**DESIGN LOAD:**

AASHTO HS25-44 LIVE LOAD  
SEISMIC DESIGN CATEGORY B.

**SPECIFICATIONS:**

AASHTO STANDARD SPECIFICATIONS FOR HIGHWAY BRIDGES, SIXTEENTH EDITION, 1996, AS MODIFIED BY NHDOT BRIDGE DESIGN MANUAL.  
NHDOT STANDARD SPECIFICATIONS FOR ROAD AND BRIDGE CONSTRUCTION, 1997 WITH CURRENT ADDITIONS AND MODIFICATIONS.

**FOUNDATIONS:**

NEW CAST-IN-PLACE CONCRETE ABUTMENTS WITH RECONSTRUCTED BLOCK STONE WINGWALLS.

**SUPERSTRUCTURE:**

SINGLE SPAN PRECAST CONCRETE DECK BEAMS WITH NON-COMPOSITE, CONCRETE OVERLAY WITH HIGH RANGE WATER REDUCING ADMIXTURE.

**CONCRETE:**

CONCRETE DESIGN STRESSES ARE BASED UPON A 28-DAY COMPRESSIVE STRENGTH OF:  
f'c = 6,000 PSI, FOR PRECAST DECK BEAMS  
f'c = 4,000 PSI, CONCRETE OVERLAY INCLUDING HIGH RANGE WATER REDUCING ADMIXTURE  
f'c = 4,000 PSI, CLASS AA FOR BRIDGE SEATS, SAFETY CURBS, SIDEWALKS AND ABUTMENT CAP  
f'c = 3,000 PSI, CLASS A FOR ABUTMENT WALLS.  
f'c = 3,000 PSI, CLASS B FOR FOOTINGS.  
ALL EXPOSED EDGES OF CONCRETE SHALL BE CHAMFERED 3/8" EXCEPT AS NOTED.

**REINFORCING STEEL:**

ALL REINFORCING STEEL SHALL CONFORM TO AASHTO M31 (ASTM-A615), GRADE 60.  
REINFORCING STEEL FOR BRIDGE DECK OVERLAY SHALL BE WELDED WIRE FABRIC (WWF6x6 - W4.0xW4.0), EPOXY COATED CONFORMING TO AASHTO M55 (ASTM A185-79).  
CONCRETE COVER MEASURED FROM THE FACE OF REINFORCING STEEL SHALL BE 2 1/2" EXCEPT AS NOTED.

**PRESTRESSING STEEL:**

PRESTRESSING AND POST-TENSIONING STRANDS SHALL BE LOW RELAXATION SEVEN WIRE STRANDS CONFORMING TO AASHTO M203 (ASTM A416) GRADE 270.

**HYDROLOGIC/HYDRAULICS:**

DESIGN YEAR STORM EVENT = 100 YEAR  
DRAINAGE AREA = 51.2 SQUARE MILES  
DESIGN FLOOD VOLUME, Q<sub>100</sub> = 2465 CFS  
DESIGN FLOOD VELOCITY, V<sub>100</sub> = 8.73 FPS


**VERTICAL CURVE DATA**

P.V.I. STA = 11+62.00  
P.V.I. EL. = 154.60  
LENGTH = 200'  
AD = 4.6  
K = 43.44  
GRADE IN = -1.30%  
GRADE OUT = +3.30%

**HORIZONTAL CURVE DATA**

P.I. STA = 10+95.89  
Δ = 10°54'35"  
D = 9°05'40"  
T = 60.16  
L = 119.96  
E = 2.87  
R = 630.00


**AS-BUILT (OCTOBER 31, 1998)**

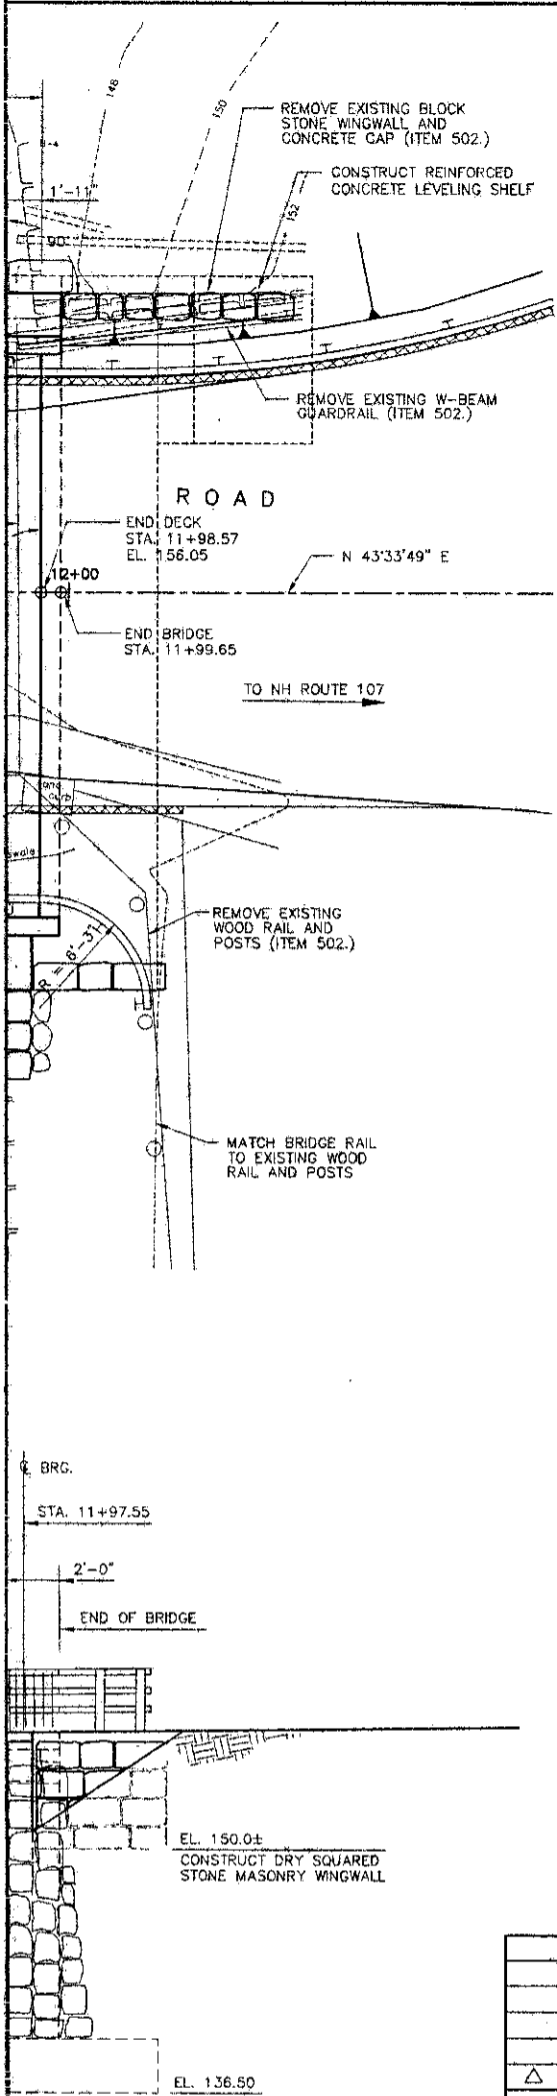

**GENERAL PLAN and ELEVATION**

TOWN <b>FREMONT</b>		BRIDGE NO. <b>096/095</b>	
LOCATION <b>SANDOWN ROAD BRIDGE OVER EXETER RIVER</b>			
DESIGNED BY <b>MAS</b>	DATE <b>3/97</b>	CHECKED BY <b>WRB</b>	DATE <b>8/97</b>
DRAWN BY <b>MTB</b>	DATE <b>3/97</b>	CHECKED BY <b>MAS</b>	DATE <b>4/97</b>
REVISION DESCRIPTION		BY	DATE
BA&C Project No. 96071.00		BA&C CAD File	PGENPLN.DWG
STATE FILE NO.		STATE PROJECT NO.	SHEET NO. TOTAL SHEETS
		12544	5 24

**BAC Killam**  
THE CONCORD CENTER  
10 FERRY STREET  
CONCORD, NH 03301

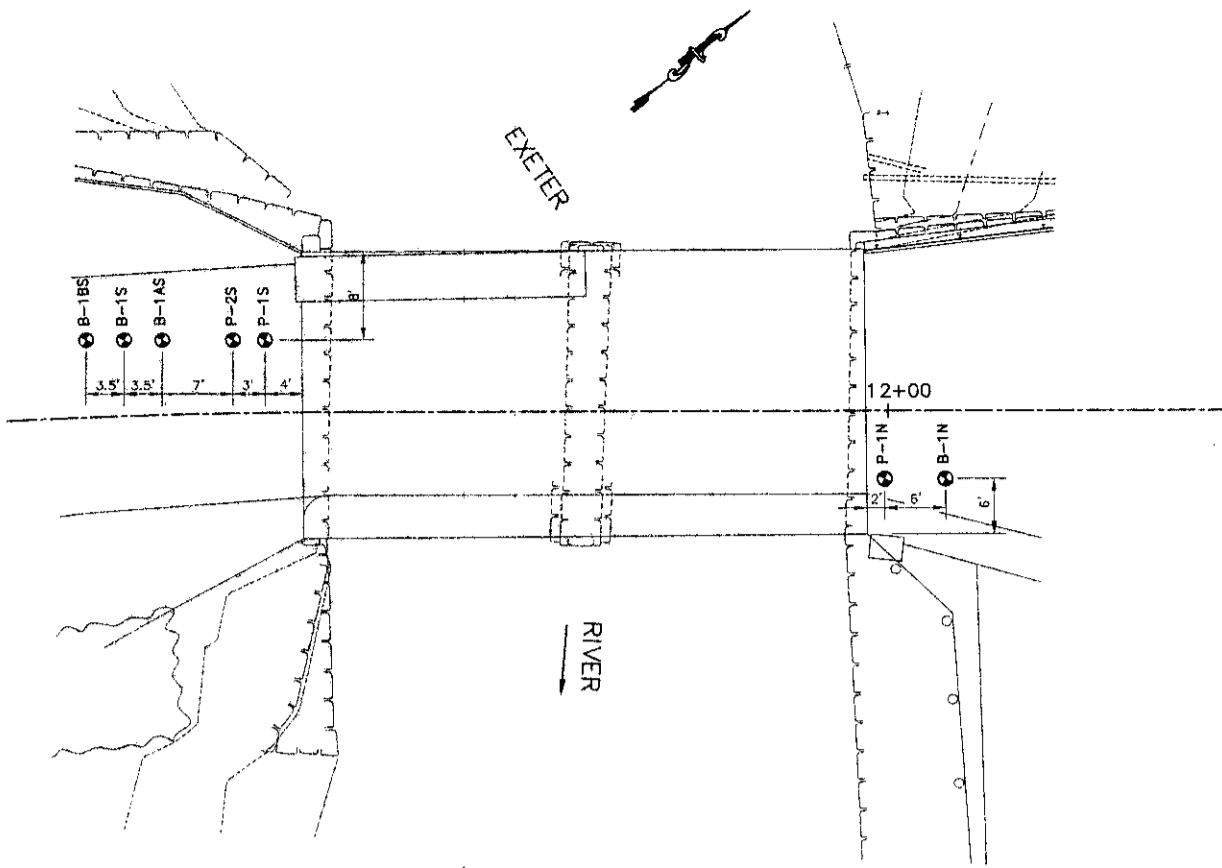

**BORING LOCATIONS**  
NTS

● B-1AS

VATION = 155.6

CASING	SAMPLE	CORE	GROUNDWATER		DEPTH TO		
			DATE	TIME	WATER	BOTTOM OF CASING	BOTTOM OF HOLE
HSA							
4 1/4"							

SAMPLE NUMBER	SAMPLE DEPTH	SAMPLE BLOWS PER 6 inches	RECOVERY	SOIL DESCRIPTION	
				SAND, GRAVEL, and FILL (Very Hard Drilling)	
				9.0'	
				Drilled into boulder with 4" roller bit to 11'	
				BOTTOM OF BORING	11.0'
				Note: Typed driller's field log.	

**NOTES:**

BORINGS PERFORMED BY: CON-TEC INC.  
P.O. BOX 1153  
CONCORD, N.H. 03302 - 1153  
Phone: 603-224-0020

DRILLER: T. Flores  
HELPER: J. Edge  
INSPECTOR:

Borings completed 10/8/96 & 10/9/96

AS-BUILT (OCTOBER 31, 1998)

<b>SANDOWN ROAD BORING LOGS FREMONT, N.H.</b>		
	<small>BAC Kilam THE CONCORD CENTER 10 FERRY STREET CONCORD, NH 03301</small>	<small>FILE NUMBER</small> <b>93-2-1</b>
<small>BAC PROJECT NO.</small> 96071	<small>BAC CAD FILENAME</small> BORINGS.DWG	<small>FEDERAL PROJECT NO.</small> 12544
<small>STATE PROJECT NO.</small> 6	<small>SHEET NO.</small> 24	<small>TOTAL SHEETS</small> 24

P-1S

ATION = 155.8

CASING	SAMPLE	CORE	GROUNDWATER		DEPTH TO		
			DATE	TIME	WATER	BOTTOM OF CASING	BOTTOM OF HOLE
SSA							
4"							

SAMPLE NUMBER	SAMPLE DEPTH	SAMPLE BLOWS PER 6 Inches	RECOVERY	SOIL DESCRIPTION	
				ASPHALT	0.5'
				GRAVEL, COBBLES, and BOULDERS (Very Hard Drilling)	
				Auger Refusal	5.0'
				BOTTOM OF PROBE	5.0'
				Note: Typed driller's field log.	

B-1N

ATION = 156.3

CASING	SAMPLE	CORE	GROUNDWATER		DEPTH TO		
			DATE	TIME	WATER	BOTTOM OF CASING	BOTTOM OF HOLE
HSA	SS						
4 1/2"	1 1/2"		10/8		10'		24.8'
	140						
	30"						

SAMPLE NUMBER	SAMPLE DEPTH	SAMPLE BLOWS PER 6 Inches	RECOVERY	SOIL DESCRIPTION	
1	0.5'-2.5'	19 18 - 14 16	10"	ASPHALT	0.5'
				Dark grey, dry, dense f/m/c SAND, and f/ GRAVEL	3.0'
2	4'-6'	5 - 4 4 - 4	12"	Light brown, dry, loose m/f/c SAND, little f/m gravel	
3	9'-11'	3 - 2 3 - 16	6"		8.0'
				Dark brown, moist loose ORGANIC SILT, trace embedded f/m/c sand, trace embedded f/m gravel	10.5'
4	14'-16'	66 - 41 46 - 46	15"	Light brown, wet, dense to very dense f/m/c SAND and c/m/f GRAVEL, occasional cobbles	
5	20'-21'	84 - 162	10"	Light brown, moist, very dense f/m/c SAND and embedded f/m/c GRAVEL, trace silt	
6	24'-24.8'	112 - 120/4	10"	BOTTOM OF BORING	
					24.8' 24.8'
				Note: Typed driller's field log.	

NOTES:

BORINGS PERFORMED BY: CON-TEC INC.  
P.O. BOX 1153  
CONCORD, N.H. 03302 - 1153  
Phone: 603-224-0020

DRILLER: T. Flores

HELPER: J. Edge

INSPECTOR:

Borings completed 10/8/96 & 10/9/96

SEE BRIDGE SHEET 6 FOR BORING LOCATIONS.

AS-BUILT (OCTOBER 31, 1998)

SANDOWN ROAD BORING LOGS  
FREMONT, N.H.





BAC Kilam  
THE CONCORD CENTER  
10 FERRY STREET  
CONCORD, NH 03301



FILE NUMBER

93-2-1

BAC PROJECT NO.	BAC CAD FILENAME	FEDERAL PROJECT NO.	STATE PROJECT NO.	SHEET NO.	TOTAL SHEETS
96071	BORINGS.DWG		12544	7	24

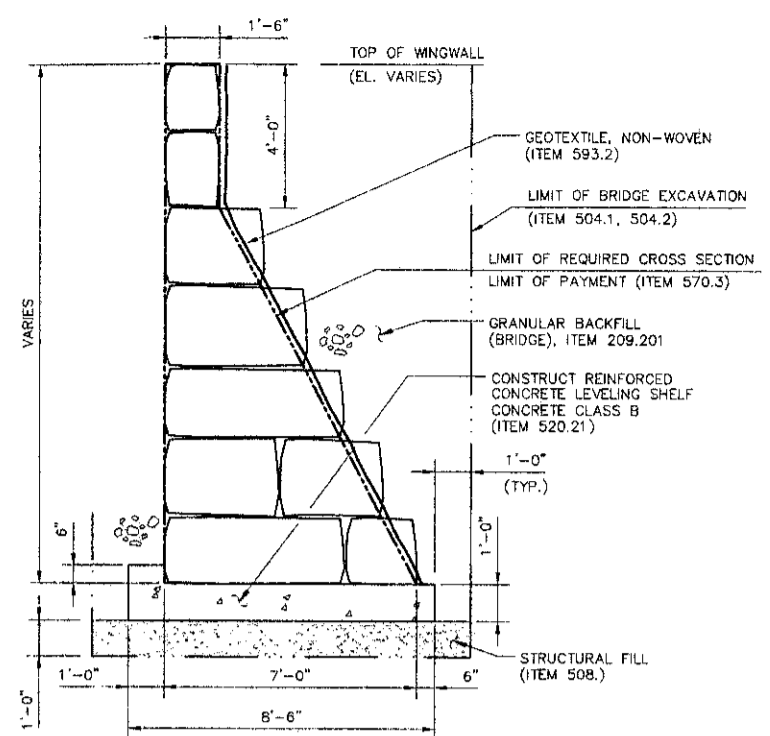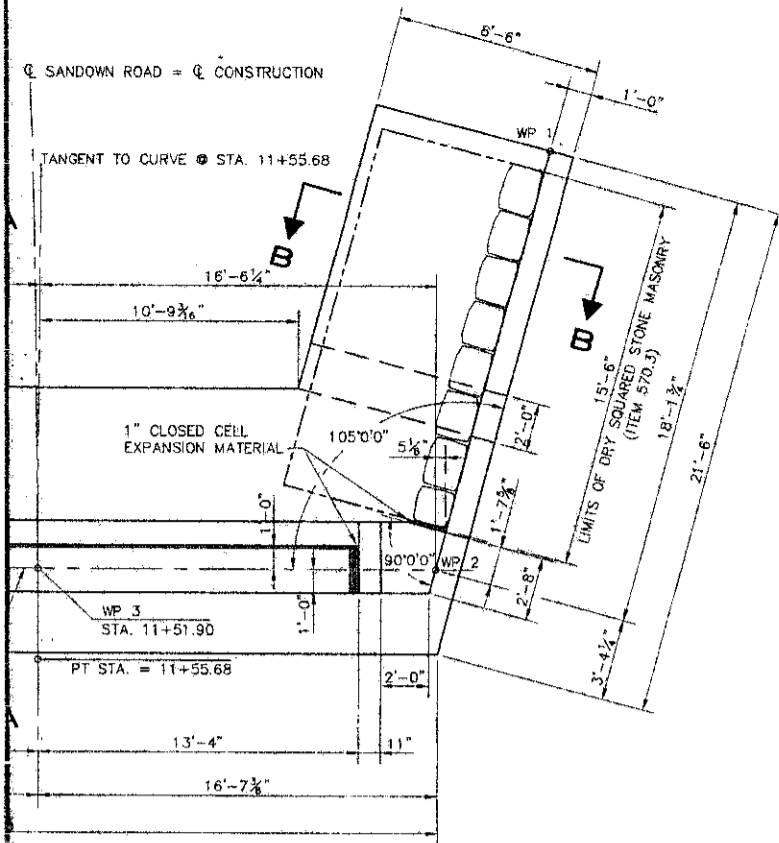

**SECTION B-B**  
SCALE: 1/8" = 1'-0"

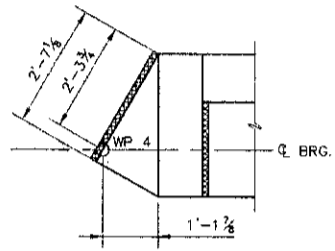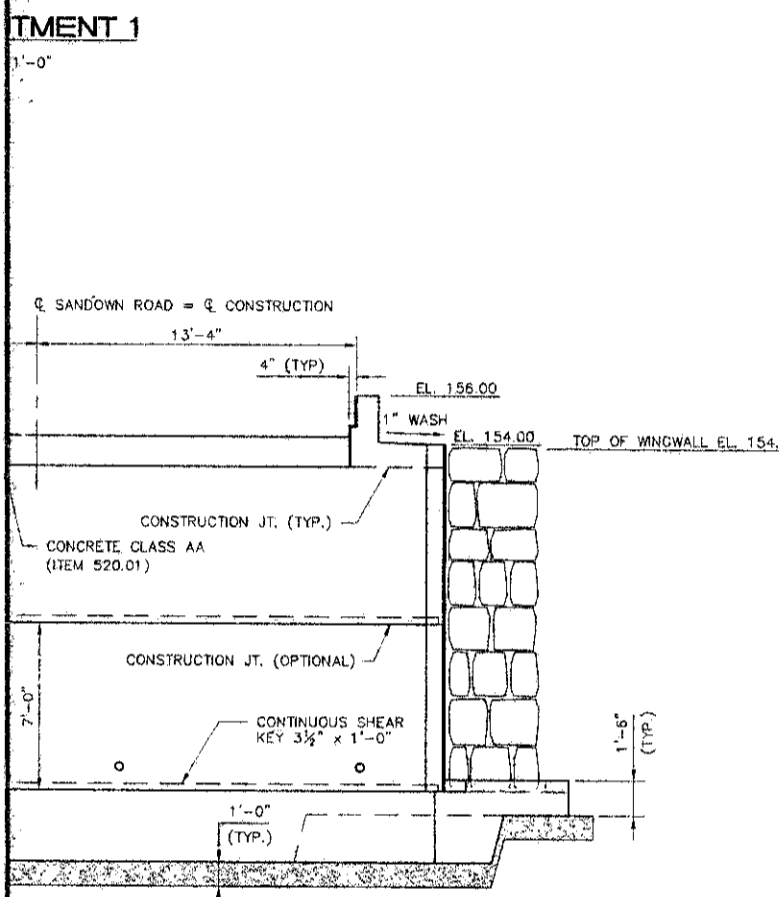


**DETAIL A**  
SCALE: 1/2" = 1'-0"

**NOTES:**


1. ALL CONCRETE IN FOOTINGS SHALL BE CONCRETE CLASS B, FOOTINGS (ITEM 520.21).
2. THE CONCRETE IN THE ABUTMENT WALL SHALL BE CONCRETE CLASS A, ABOVE FOOTINGS (ITEM 520.12).
3. THE COST OF CLOSED CELL EXPANSION MATERIAL TO BE INCLUDED IN ITEM 520.12.
4. ALL EXPOSED EDGES OF CONCRETE SHALL BE CHAMFERED 3/8\"/>

AS-BUILT (OCTOBER 31, 1998)

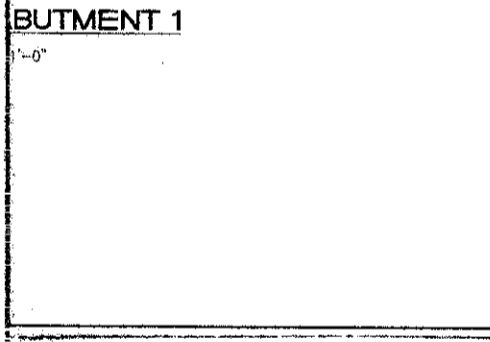


ABUTMENT 1 MASONRY									
TOWN		FREMONT		BRIDGE NO.		096/095			
LOCATION SANDOWN ROAD BRIDGE OVER EXETER RIVER									
DESIGNED	JWP	DATE	4/97	CHECKED	WRB	DATE	6/97	FILE NUMBER	93-2-1
DRAWN	MTR	DATE	4/97	CHECKED	MAS	DATE	5/97	BRIDGE SHEET NO.	
QUANTITIES				CHECKED				OF	
STATE FILE NO.		STATE PROJECT NO.		SHEET NO.		TOTAL SHEETS			
		12544		8		24			

BA&C Project No. 96071.00 BA&C CAD File ABUT1MAS.DWG

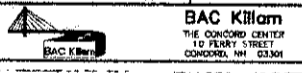


D = Q CONSTRUCTION  
 CURVE @ STA. 11+55.68

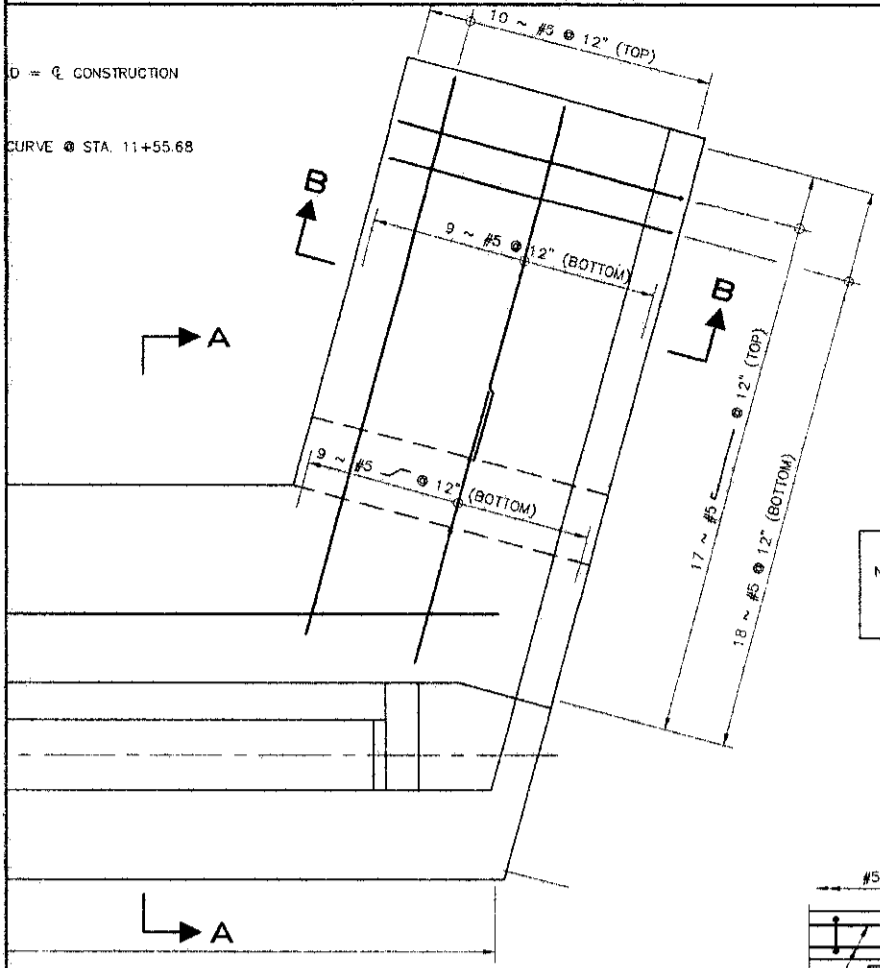


**ELEVATION - EAST LEVELING SHELF**

SCALE: 3/8" = 1'-0"

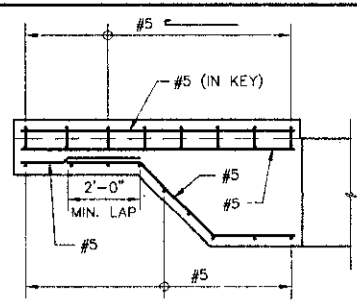


**ELEVATION - WEST LEVELING SHELF**


SCALE: 3/8" = 1'-0"

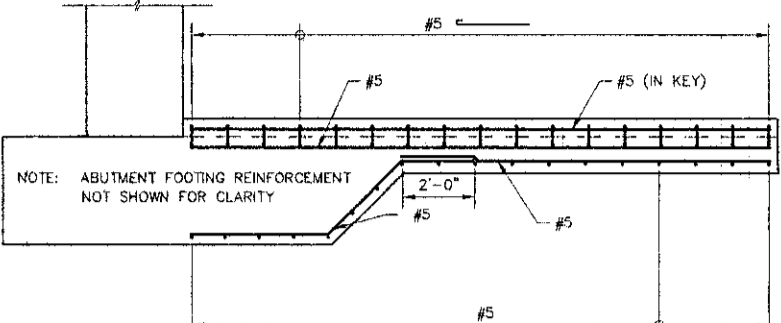

NOTE: ABUTMENT FOOTING REINFORCEMENT NOT SHOWN FOR CLARITY

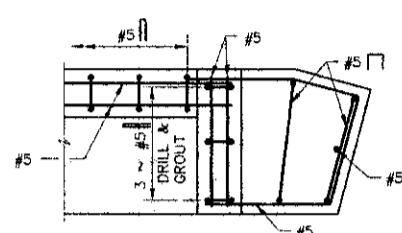


**ABOVE BRIDGE SEAT**

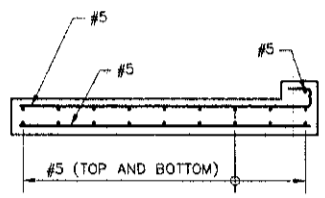

**SECTION B-B**


SCALE: 3/8" = 1'-0"

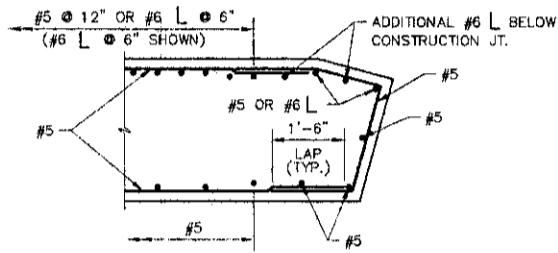

**BELOW BRIDGE SEAT**

**PLAN - WEST ENDWALL**

SCALE: 1/2" = 1'-0"

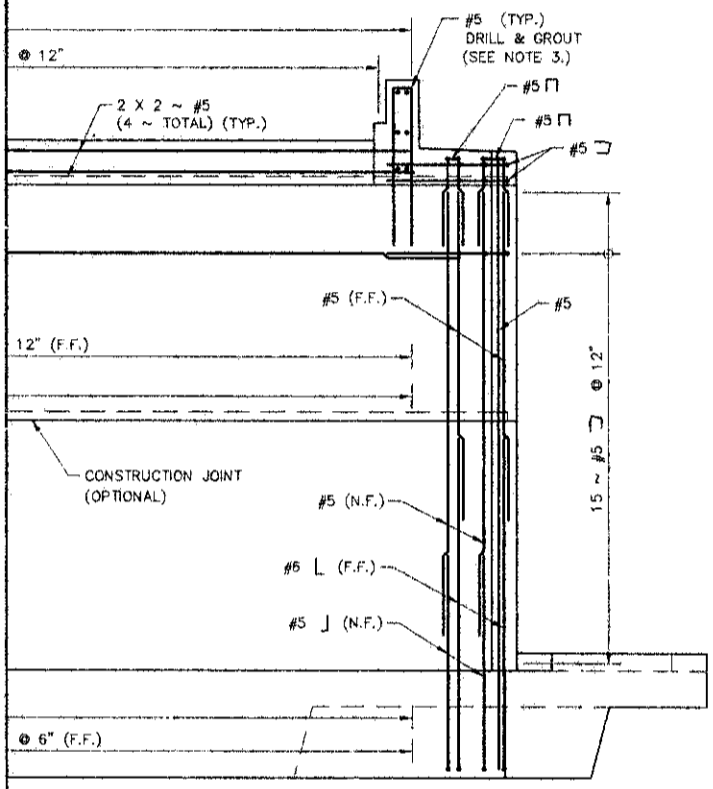

**NOTES:**

1. CONCRETE COVER MEASURED FROM THE FACE OF THE REINFORCING STEEL SHALL BE 2 1/2" EXCEPT AS NOTED.
2. SEE "ABUTMENT 2 REINFORCING" SHEET FOR SECTION A-A.
3. THE PRECAST CONCRETE DECK BEAMS SHALL BE INSTALLED AND FULLY TENSIONED PRIOR TO CONSTRUCTION OF THE ABUTMENT BACKWALL, AND KEEPER WALLS.

**LEGEND**

- N.F. NEAR FACE
- F.F. FAR FACE
- E.F. EACH FACE
- Δ CUT TO FIT IN FIELD

AS-BUILT (OCTOBER 31, 1998)

**ABUTMENT 1 REINFORCING**

TOWN	FREMONT		BRIDGE NO.	095/095	
LOCATION	SANDOWN ROAD BRIDGE OVER EXETER RIVER				
DESIGNED	JWP	DATE	4/97	CHECKED	WRB
DRAWN	MTB	DATE	4/97	CHECKED	MAS
QUANTITIES				CHECKED	
STATE FILE NO.	12544	STATE PROJECT NO.	9	SHEET NO.	24
				FILE NUMBER	93-2-1
				BRIDGE SHEET NO.	
				OF	

REVISION DESCRIPTION	BY	DATE

BAC&C Project No. 96071.00    BAC&C CAD File ABUT1REI.DWG

**BAC Kilam**  
 THE CONCORD CENTER  
 15 HENRY STREET  
 CONCORD, NH 03301


ENT 1



STATION	OFFSET
2+13.65	16.75' LT
1+97.65	16.75' LT
1+97.65	0
1+97.65	22.25' RT


LIMITS OF ITEMS 403.911, 520.85, 538.4 AND 609.3

STA. 11+49.80 AT ABUT. 1  
STA. 11+99.55 AT ABUT. 2

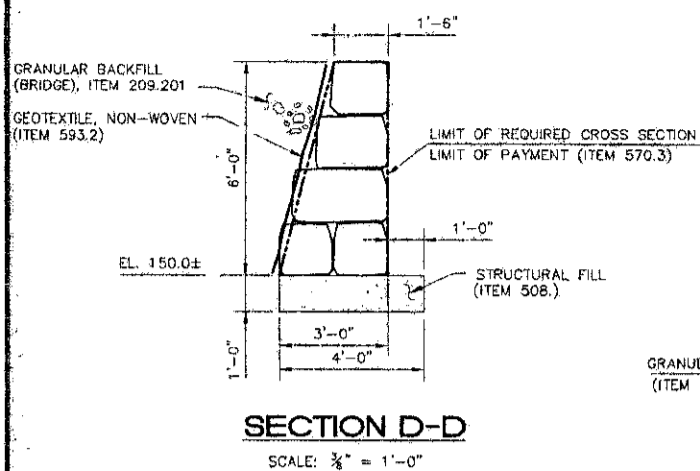

GRANULAR BACKFILL (BRIDGE), (ITEM 209.201)


LIMIT OF BRIDGE EXCAVATION (ITEM 504.1, 504.2)

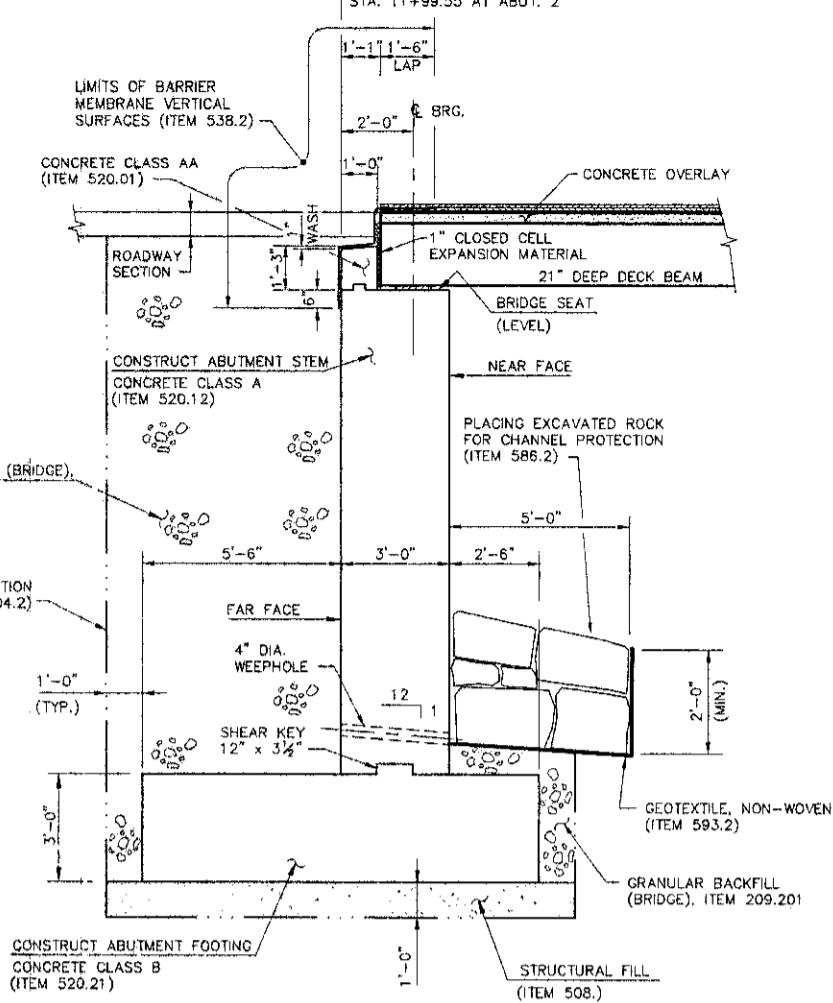

**SECTION A-A**  
SCALE: 3/8" = 1'-0"

**NOTES:**

1. ALL CONCRETE IN FOOTINGS SHALL BE CONCRETE CLASS B, FOOTINGS (ITEM 520.21).
2. THE CONCRETE IN THE ABUTMENT WALL SHALL BE CONCRETE CLASS A, ABOVE FOOTINGS (ITEM 520.12).
3. THE COST OF CLOSED CELL EXPANSION MATERIAL TO BE INCLUDED IN ITEM 520.12.
4. ALL EXPOSED EDGES OF CONCRETE SHALL BE CHAMFERED 3/8".

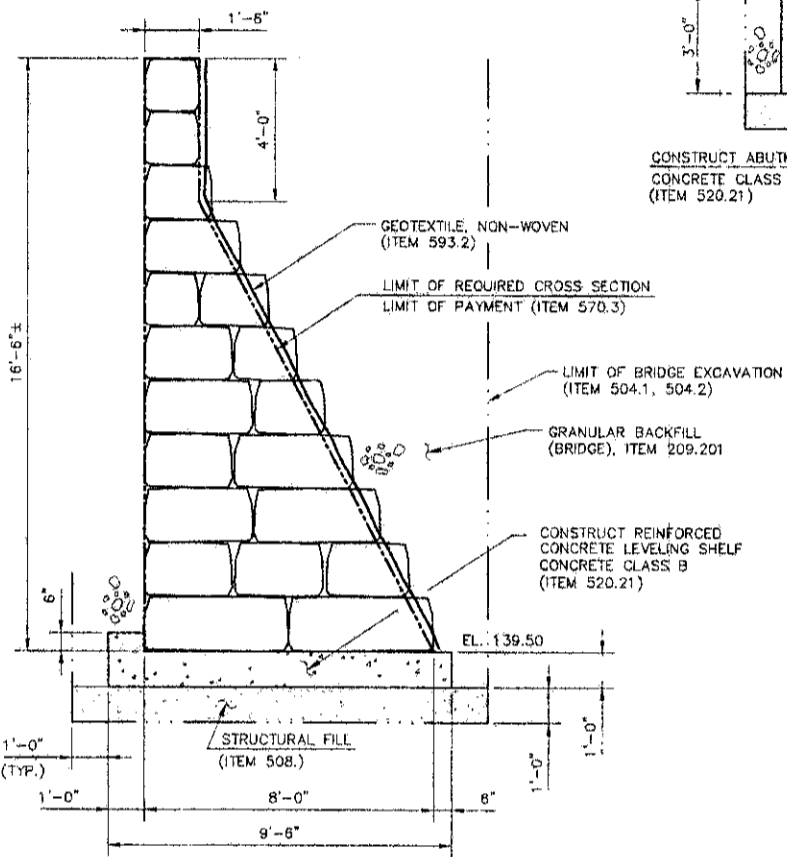


AS-BUILT (OCTOBER 31, 1998)

**ABUTMENT 2 MASONRY**


TOWN		FREMONT		BRIDGE NO.		096/095	
LOCATION		SANDOWN ROAD BRIDGE OVER EXETER RIVER					
DESIGNED	BY	DATE	CHECKED	BY	DATE	FILE NUMBER	
JWP	JWP	4/97	WRB	WRB	6/97	93-2-1	
DRAWN	BY	DATE	CHECKED	BY	DATE	BRIDGE SHEET NO.	
MTB	MTB	4/97	MAS	MAS	5/97	OF	
QUANTITIES		CHECKED					
STATE FILE NO.		STATE PROJECT NO.		SHEET NO.		TOTAL SHEETS	
		12544		10		24	

BA&C Project No. 96071.00  
BA&C CAD File ABUT2MAS.DWG  
**BAC Kilom**  
THE CONCORD CENTER  
10 HENRY STREET  
CONCORD, NH 03301

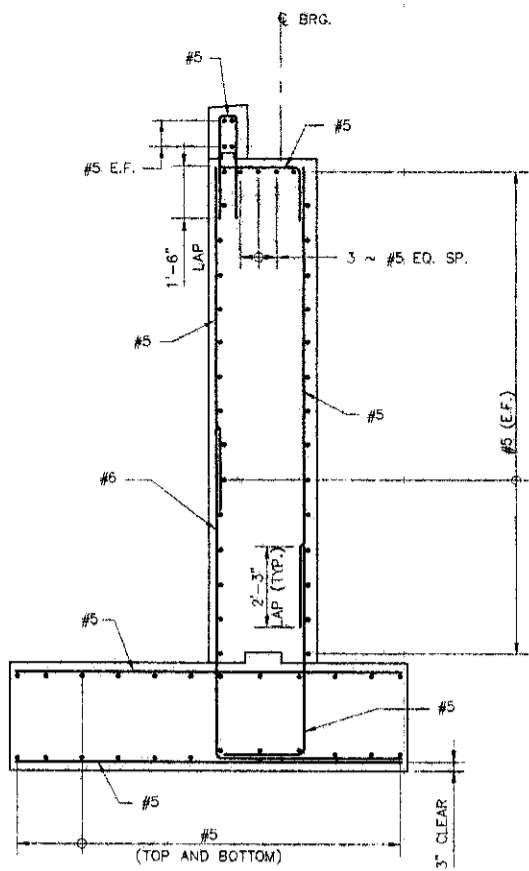


**SECTION A-A**

SCALE:  $\frac{3}{8}'' = 1'-0''$

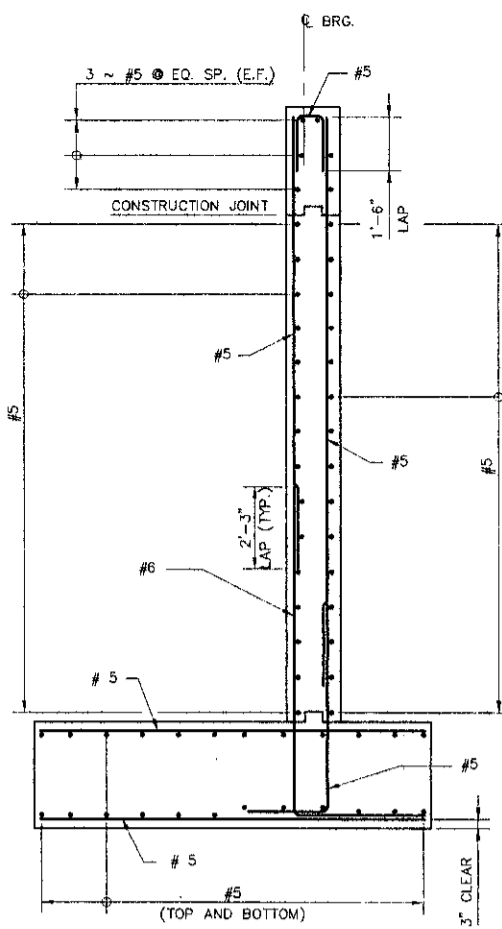


**SECTION D-D**

SCALE:  $\frac{3}{8}'' = 1'-0''$

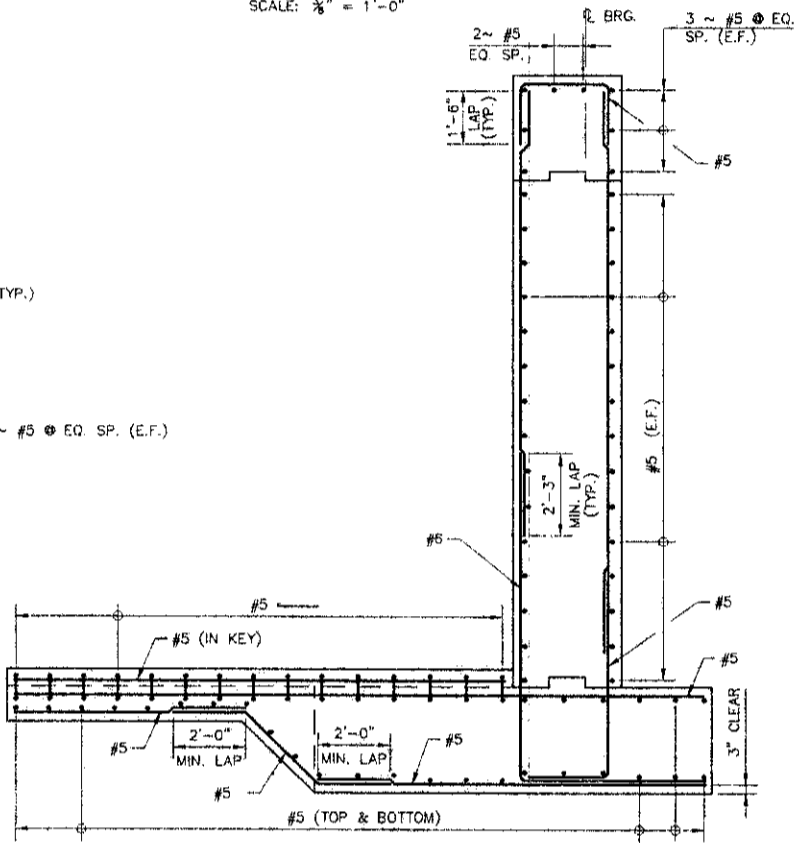

**SECTION E-E**

SCALE:  $\frac{3}{8}'' = 1'-0''$

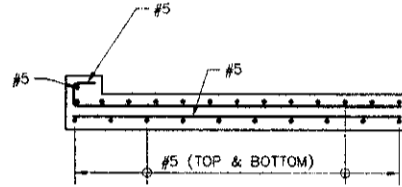

**SECTION C-C**

SCALE:  $\frac{3}{8}'' = 1'-0''$

**NOTES:**

1. CONCRETE COVER MEASURED FROM THE FACE OF THE REINFORCING STEEL SHALL BE  $2\frac{1}{2}''$  EXCEPT AS NOTED.
2. THE PRECAST CONCRETE DECK BEAMS SHALL BE INSTALLED AND FULLY TENSIONED PRIOR TO CONSTRUCTION OF THE ABUTMENT BACKWALL AND KEEPER WALLS.

AS-BUILT (OCTOBER 31, 1998)


**LEGEND**

- N.F. NEAR FACE
- F.F. FAR FACE
- E.F. EACH FACE
- Δ CUT TO FIT IN FIELD

REVISION	DESCRIPTION	BY	DATE


BA&C Project No. 96071.00  
 BAC Kilam  
 THE CONCRETE GROUP  
 10 EIGHT STREET  
 CONCORD, NH 03301

ABUTMENT 2 REINFORCING					
TOWN	FREMONT	BRIDGE NO.	096/095	FILE NUMBER	93-2-1
LOCATION	SANDOWN ROAD BRIDGE OVER EXETER RIVER				
DESIGNED	JWP	DATE	4/97	CHECKED	WRB 6/97
DRAWN	MTB	DATE	4/97	CHECKED	MAS 7/97
QUANTITIES		CHECKED			
STATE FILE NO.	12544	STATE PROJECT NO.	11	SHEET NO.	24

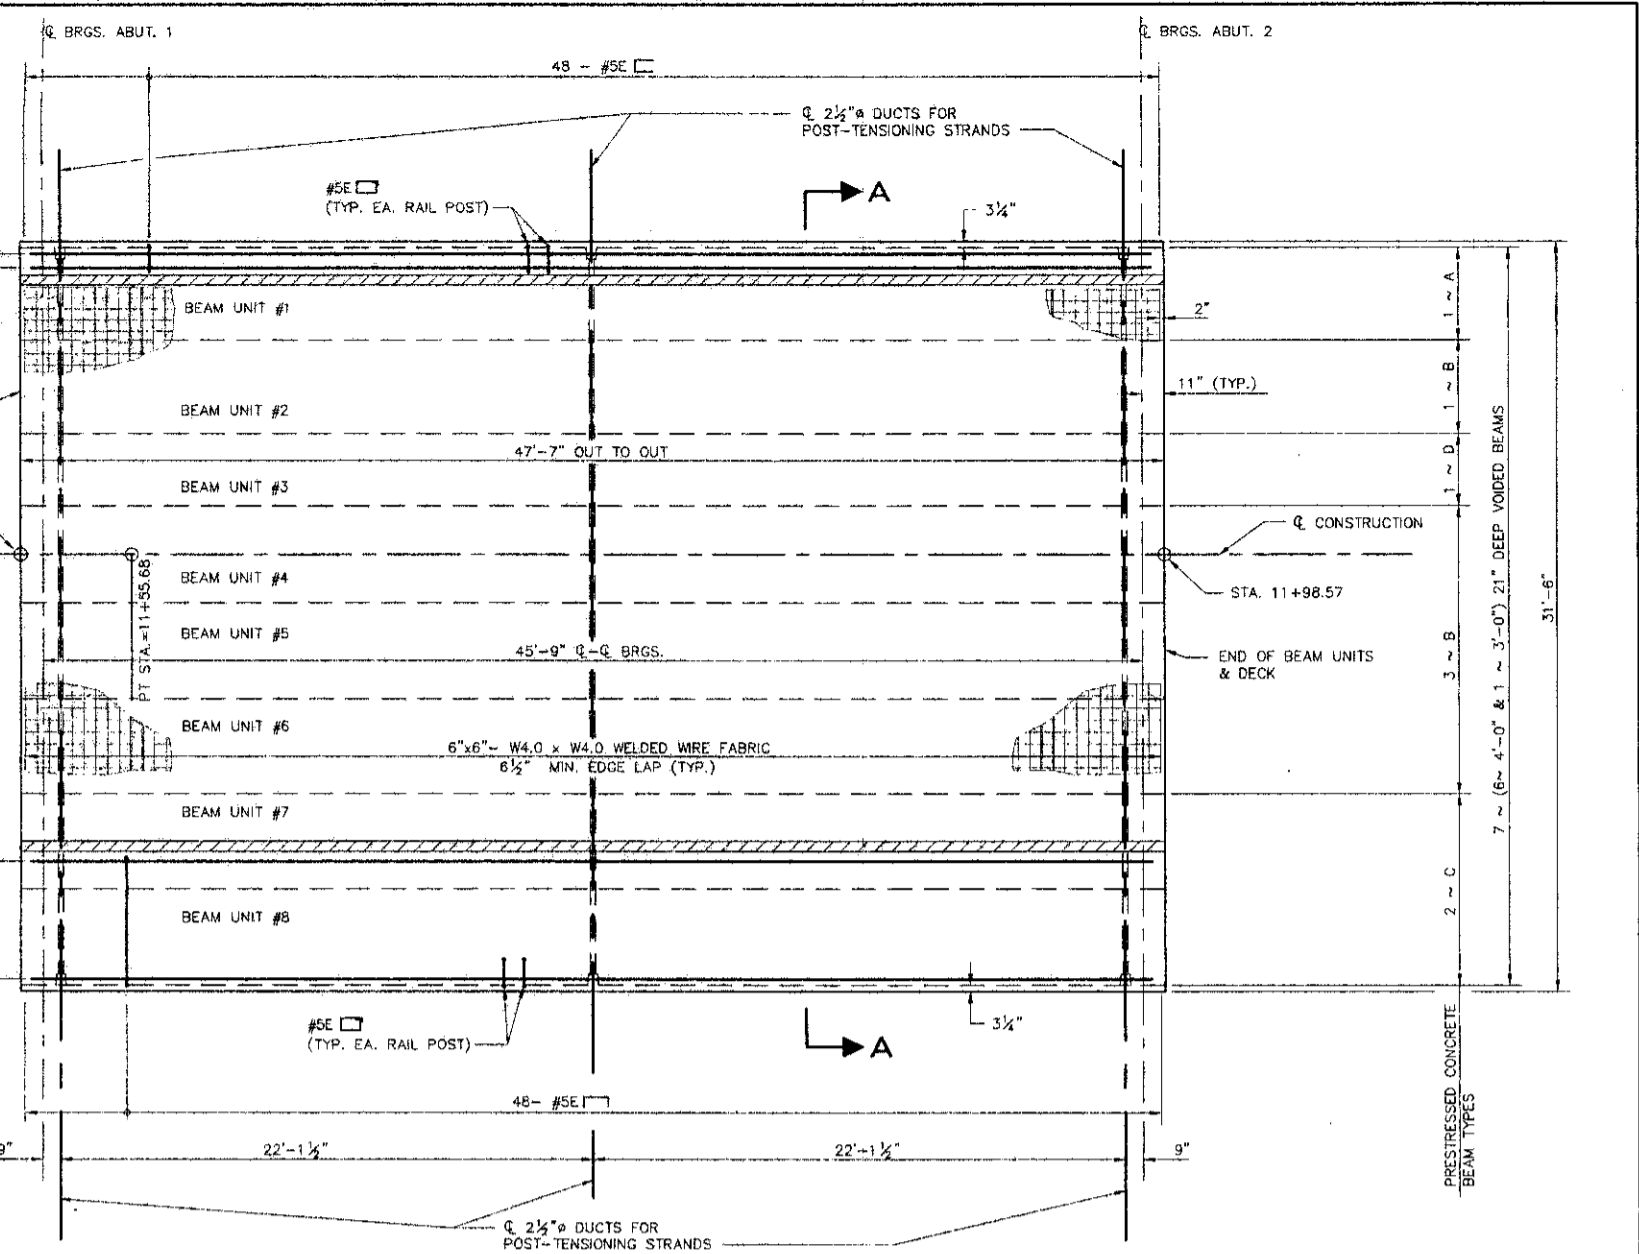

**BEAM LAYOUT/SUPERSTRUCTURE PLAN**

SCALE: 1/4" = 1'-0"

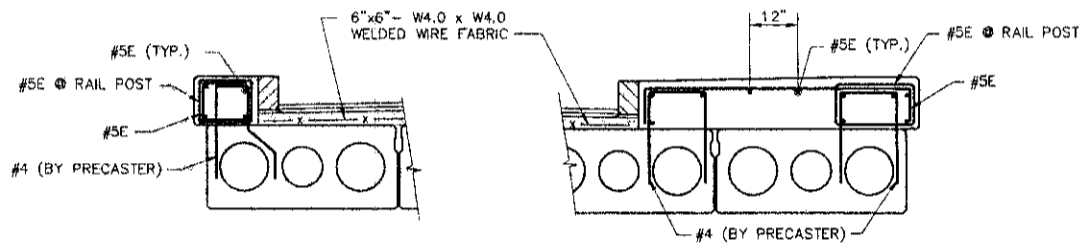

**WEST FASCIA DETAIL**

SCALE: 1/2" = 1'-0"

**EAST FASCIA DETAIL**

SCALE: 1/2" = 1'-0"

**NOTES:**

1. FOR PRESTRESSED CONCRETE BEAMS, SEE SHEETS 13 AND 14.
2. FOR PRESTRESSED CONCRETE BEAM DETAILS, SEE SHEET 15.
3. REINFORCING DESIGNATED WITH AN "E" SHALL BE EPOXY COATED.
4. THE COST OF FURNISHING AND INSTALLING ALL REINFORCING FOR BRUSH CURB AND SIDEWALK TO BE INCLUDED UNDER ITEM 544.2

AS-BUILT (OCTOBER 31, 1998)

DECK PLAN and TRANSVERSE SECTION							
TOWN		FREMONT		BRIDGE NO.		096/095	
LOCATION SANDOWN ROAD BRIDGE OVER EXETER RIVER							
DESIGNED	MAS	DATE	4/97	CHECKED	JWP	DATE	5/97
DRAWN	MTB	DATE	4/97	CHECKED	MAS	DATE	5/97
QUANTITIES				CHECKED			
STATE FILE NO.		STATE PROJECT NO.		SHEET NO.		TOTAL SHEETS	
		12544		12		24	

REVISION	DESCRIPTION	BY	DATE
△	REVISION DESCRIPTION		
BA&C Project No. 95071.00		BA&C CAD File DECKPLAN.DWG	


**BAC Kilam**  
THE CONCORD CENTER  
10 FERRY STREET  
CONCORD, NH 03301

LIMIT OF WATER REPELLENT (SILANE-SILOXANE) (ITEM 534.3)


CONCRETE CLASS AA (ITEM 520.01)

SEE DRIP NOTCH DETAIL (TYP.)

ED CONCRETE

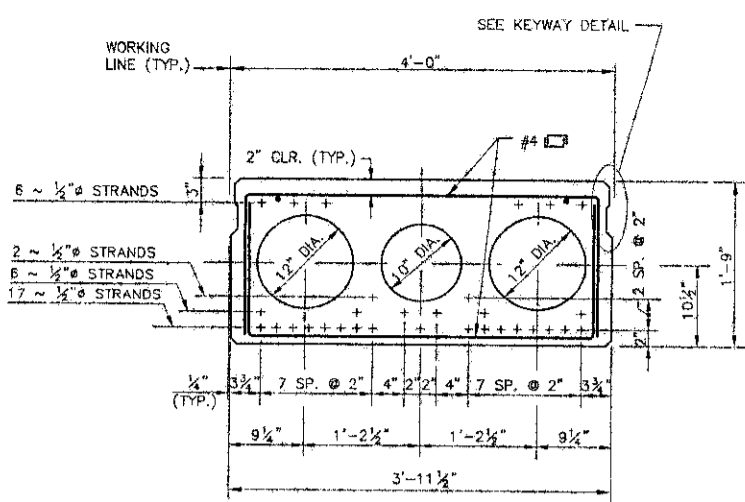


**MIDSPAN SECTION**  
SCALE: 1" = 1'-0"

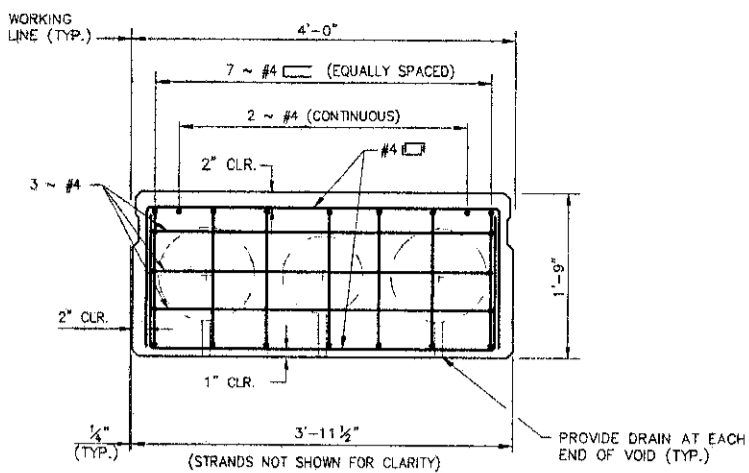


**END SECTION**  
SCALE: 1" = 1'-0"

**TYPE B - PRESTRESSED CONCRETE BEAM**

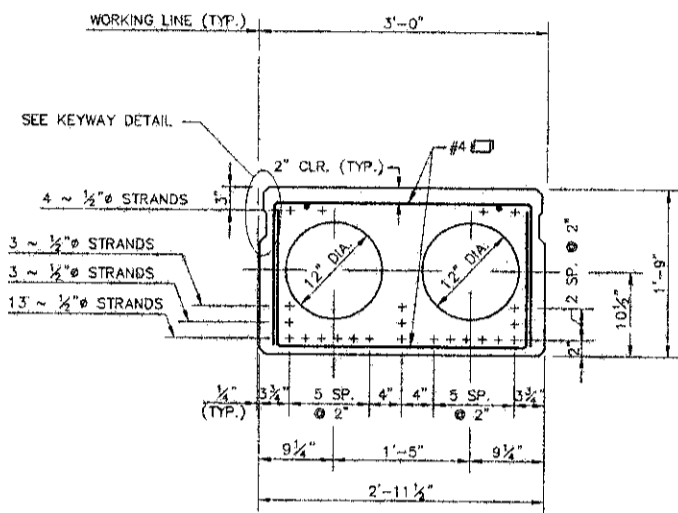

**MIDSPAN SECTION**  
SCALE: 1" = 1'-0"

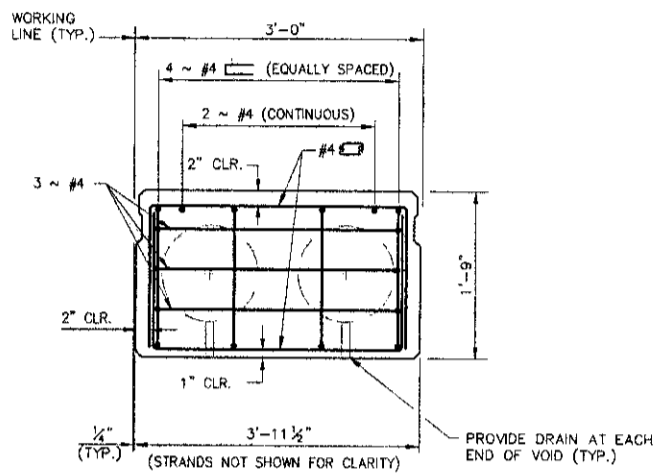


**END SECTION**  
SCALE: 1" = 1'-0"

**TYPE D - PRESTRESSED CONCRETE BEAM**

**NOTES:**

1. ALL DIMENSIONS SHOWN ARE HORIZONTAL.
2. FOR BEAM LAYOUT/SUPERSTRUCTURE PLAN, SEE SHEET 12.
3. FOR PRESTRESSED CONCRETE BEAMS, ALSO SEE SHEET 14.
4. FOR PRESTRESSED CONCRETE BEAM DETAILS, SEE SHEET 15.
5. BLAST CLEAN KEYWAY SURFACES AT PLANT.
6.  $f'_c = 6000$  P.S.I.  $f_{el} = 4800$  P.S.I.
7. ALL BARS TO BE EPOXY COATED.
8. COST OF ALL REINFORCING IN PRESTRESSED BEAMS SHALL BE INCLUDED IN ITEM 529.1.

AS-BUILT (OCTOBER 31, 1998)

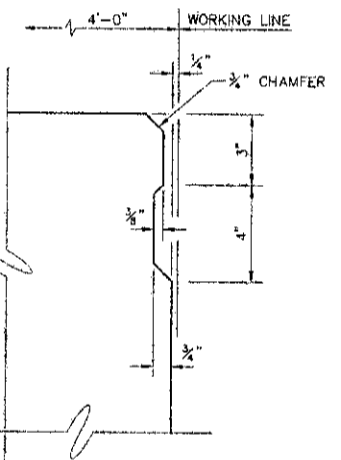


**PRESTRESSED CONCRETE BEAM KEYWAY DETAIL**  
SCALE: 3" = 1'-0"

**PRESTRESSED CONCRETE BEAMS**

TOWN		FREMONT		BRIDGE NO.		096/095	
LOCATION		SANDOWN ROAD BRIDGE OVER EXETER RIVER					
DESIGNED	JWP	DATE	5/97	CHECKED	TJM	DATE	6/97
DRAWN	MTR	DATE	5/97	CHECKED	MAS	DATE	7/97
QUANTITIES				CHECKED			
FILE NUMBER		93-2-1					
BRIDGE SHEET NO.		OF .					
STATE FILE NO.	12544	STATE PROJECT NO.	13	SHEET NO.	13	TOTAL SHEETS	24


BA&C Project No. 56071.00 BA&C CAD File CONCBM2.DWG

**BAC Kilam**  
THE CONCRETE CENTER  
10 FERRY STREET  
CONCORD, NH 03301

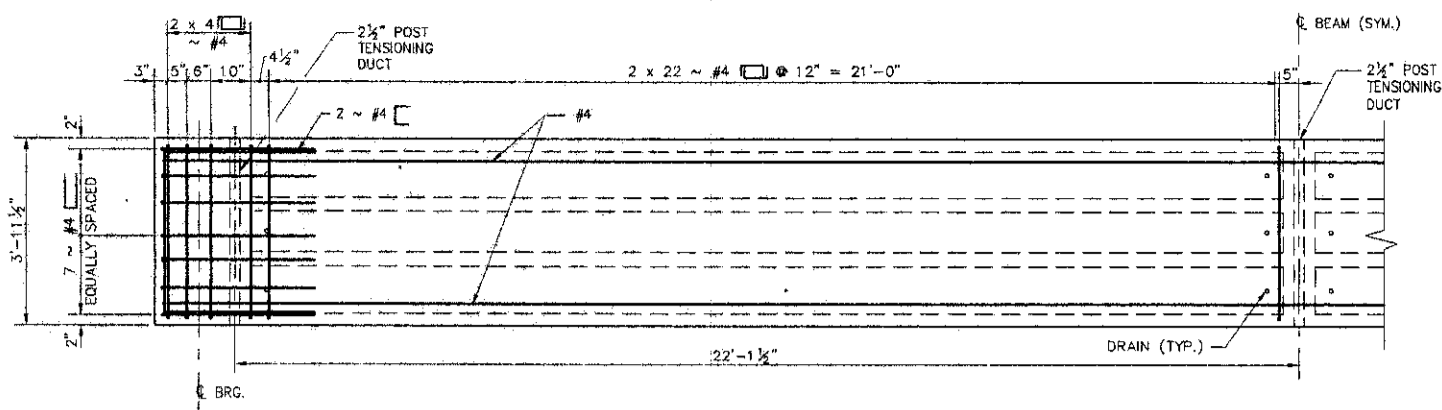

**HALF PLAN**

SCALE: 1/2" = 1'-0"

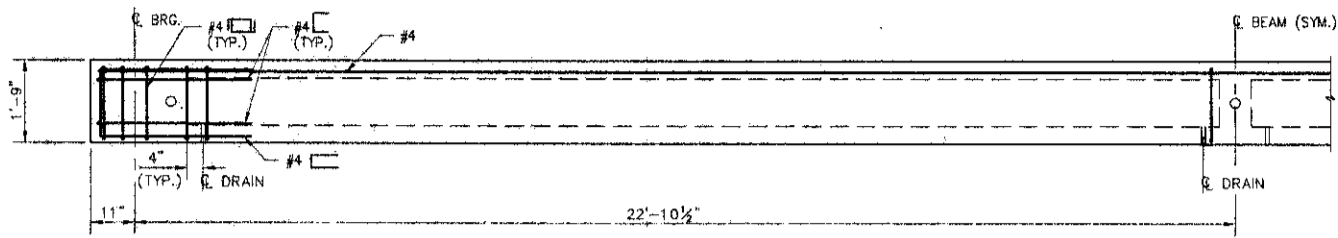


**HALF ELEVATION**

SCALE: 1/2" = 1'-0"


**TYPE B - PRESTRESSED CONCRETE BEAM**

(FOUR REQUIRED)

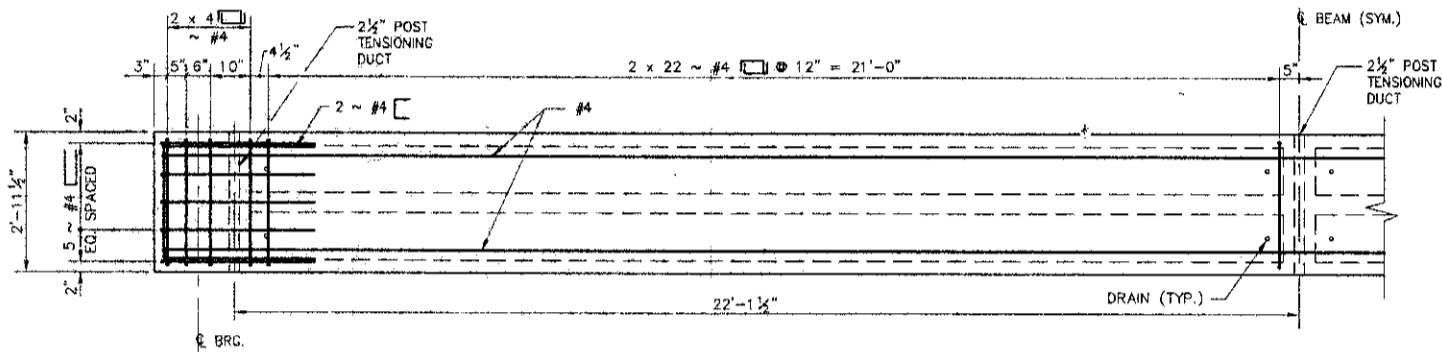

**HALF PLAN**

SCALE: 1/2" = 1'-0"

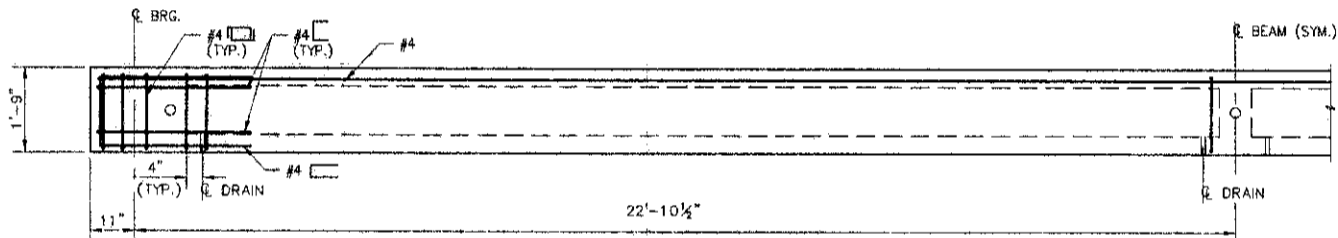

**HALF ELEVATION**


SCALE: 1/2" = 1'-0"


**TYPE D - PRESTRESSED CONCRETE BEAM**

(ONE REQUIRED)

AS-BUILT (OCTOBER 31, 1998)

ALL DIMENSIONS ARE HORIZONTAL.  
 REFER TO STRUCTURE PLAN, SEE SHEET 12.  
 REFER TO PRESTRESSED CONCRETE BEAMS, ALSO SEE SHEET 13.  
 REFER TO PRESTRESSED CONCRETE BEAM DETAILS, SEE SHEET 15.  
 ALL SURFACES AT PLANT.  
 STRENGTH = 4800 P.S.I.  
 ALL BEAMS TO BE GALVANNEAL COATED.  
 ALL REINFORCEMENT IN PRESTRESSED BEAMS SHALL BE #4.

PRESTRESSED CONCRETE BEAMS									
TOWN		FREMONT		BRIDGE NO.		096/095			
LOCATION		SANDOWN ROAD BRIDGE OVER EXETER RIVER							
DESIGNED	JWP	DATE	5/97	CHECKED	IJM	DATE	6/97	FILE NUMBER	93-2-1
DRAWN	MTB	DATE	5/97	CHECKED	MAS	DATE	7/97	BRIDGE SHEET NO.	
REVISION DESCRIPTION		BY	DATE	QUANTITIES		CHECKED		OF	
BAC Project No. 95071.00		BAC CAD File CONCBM1.DWG		STATE FILE NO.		STATE PROJECT NO.		SHEET NO.	TOTAL SHEETS
 BAC Kilom THE CONCORD CENTER 10 FERRY STREET CONCORD, NH 03301				12544		14		24	

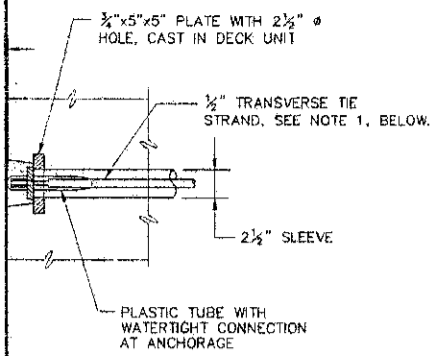

STRANDS SHALL BE 1/2" DIA. SEVEN-WIRE STRANDS CONFORMING (ASTM A416) GRADE 270, LOW RELAXATION. POST-TENSIONING BE COMPLETELY COATED WITH A SEAMLESS POLYPROPYLENE SHEATH OR PREVENTATIVE COATING SUCH AS FLO-GARD, AS MANUFACTURED BY LANG TENDONS, JACKSONVILLE, FLORIDA; POLYSTRAND, AS MANUFACTURED BY LANG TENDONS, INC., TOUGHKENAMON, PA. OR APPROVED EQUAL SUBSIDIARY TO ITEM 529.1.

ANCHORAGE POCKETS SHALL BE AN APPROVED NON-SHRINK TYPE. THE SAME COLOR AND TEXTURE AS THE BEAM CONCRETE. COST SHALL BE AS SHOWN TO ITEM 529.1.

ANCHORAGE SYSTEMS MAY BE SUBSTITUTED WITH THE APPROVAL OF THE ENGINEER. ALL ANCHORAGE SYSTEMS SHALL BE WATERTIGHT AND CORROSION RESISTANT.

**TRANSVERSE TIE POCKET DETAIL**



SCALE: 1/2" = 1'-0"

**PRESTRESS BEAM NOTES:**

1. PRETENSIONING ELEMENTS SHALL BE 1/2" DIA. UNCOATED, SEVEN-WIRE, LOW RELAXATION STEEL STRANDS, GRADE 270, CONFORMING TO AASHTO M 203 (ASTM A416). THE INITIAL PRESTRESSING FORCE PER STRAND SHALL EQUAL 30,983 POUNDS.
2. ALL REINFORCEMENT SHALL CONFORM TO AASHTO M31 (ASTM-615) GRADE 60, EPOXY COATED.
3. ALL REINFORCEMENT AND PRESTRESSING STRANDS THAT ARE CAST IN THE DECK BEAMS SHALL BE INCLUDED IN ITEM 529.1.
4. THE CONCRETE COMPRESSIVE STRENGTH SHALL BE A MINIMUM OF 4,800 PSI AT RELEASE, AND 6,000 PSI AT 28 DAYS.
5. THE DRILLING OF HOLES IN BEAMS OR THE USE OF POWER ACTUATED TOOLS ON BEAMS WILL NOT BE PERMITTED.
6. BEAM ENDS SHALL BE VERTICAL AFTER APPLICATION OF FULL DEAD LOAD.

**TRANSVERSE TIE TENSIONING NOTES:**

1. AFTER ALL BEAMS HAVE BEEN ERECTED, INITIALLY POST TENSION EACH TRANSVERSE TIE TO 5,000 POUNDS.
2. PLACE GROUT IN ALL SHEAR KEYS AND ALLOW TO CURE. IF THE SHEAR KEYS ARE NOT FILLED WITHIN 5 DAYS AFTER THE BEAMS ARE ERECTED, THE CONTRACTOR SHALL COVER AND PROTECT THE SHEAR KEYS FROM WEATHER AND DEBRIS UNTIL THEY ARE FILLED.
3. AFTER THE GROUT HAS CURED, FULLY TENSION EACH TRANSVERSE TIE TO 30,000 POUNDS. NO TRAFFIC OR HEAVY EQUIPMENT WILL BE PERMITTED ON THE BEAMS UNTIL ALL TIES HAVE BEEN FULLY TENSIONED.
4. CONCRETE FOR THE OVERLAY AND SIDEWALK SHALL BE PLACED AFTER THE TRANSVERSE TIES HAVE BEEN FULLY TENSIONED.

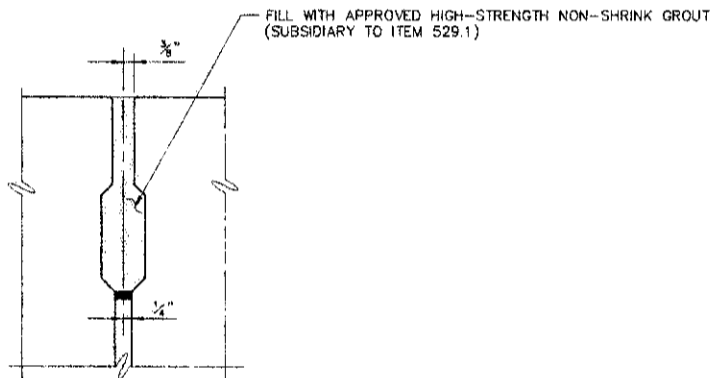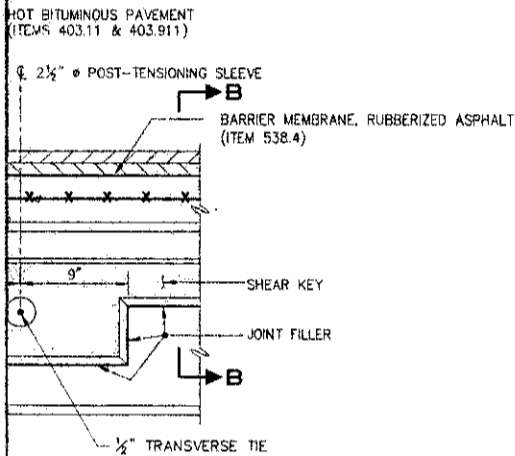

AS-BUILT (OCTOBER 31, 1998)

SECTION A-A


SECTION B-B

N.T.S.

**PRESTRESSED CONCRETE BEAM DETAILS**

TOWN <b>FREMONT</b>		BRIDGE NO. <b>096/095</b>				
LOCATION <b>SANDOWN ROAD OVER EXETER RIVER</b>						
DESIGNED	JWP	5/97	CHECKED	MAS	7/97	FILE NUMBER <b>93-2-1</b>
DRAWN	MTR	5/97	CHECKED	MAS	7/97	
REVISION DESCRIPTION		BY	DATE	BRIDGE SHEET NO.		
BA&C Project No. 96071.00		BA&C CAD File	BEAMDTLS.DWG	OF		
STATE FILE NO.		STATE PROJECT NO.	SHEET NO.	TOTAL SHEETS		
		12544	15	24		

**BAC Kilom**  
THE CONCRETE CENTER  
10 FERRY STREET  
CONCORD, NH 03301

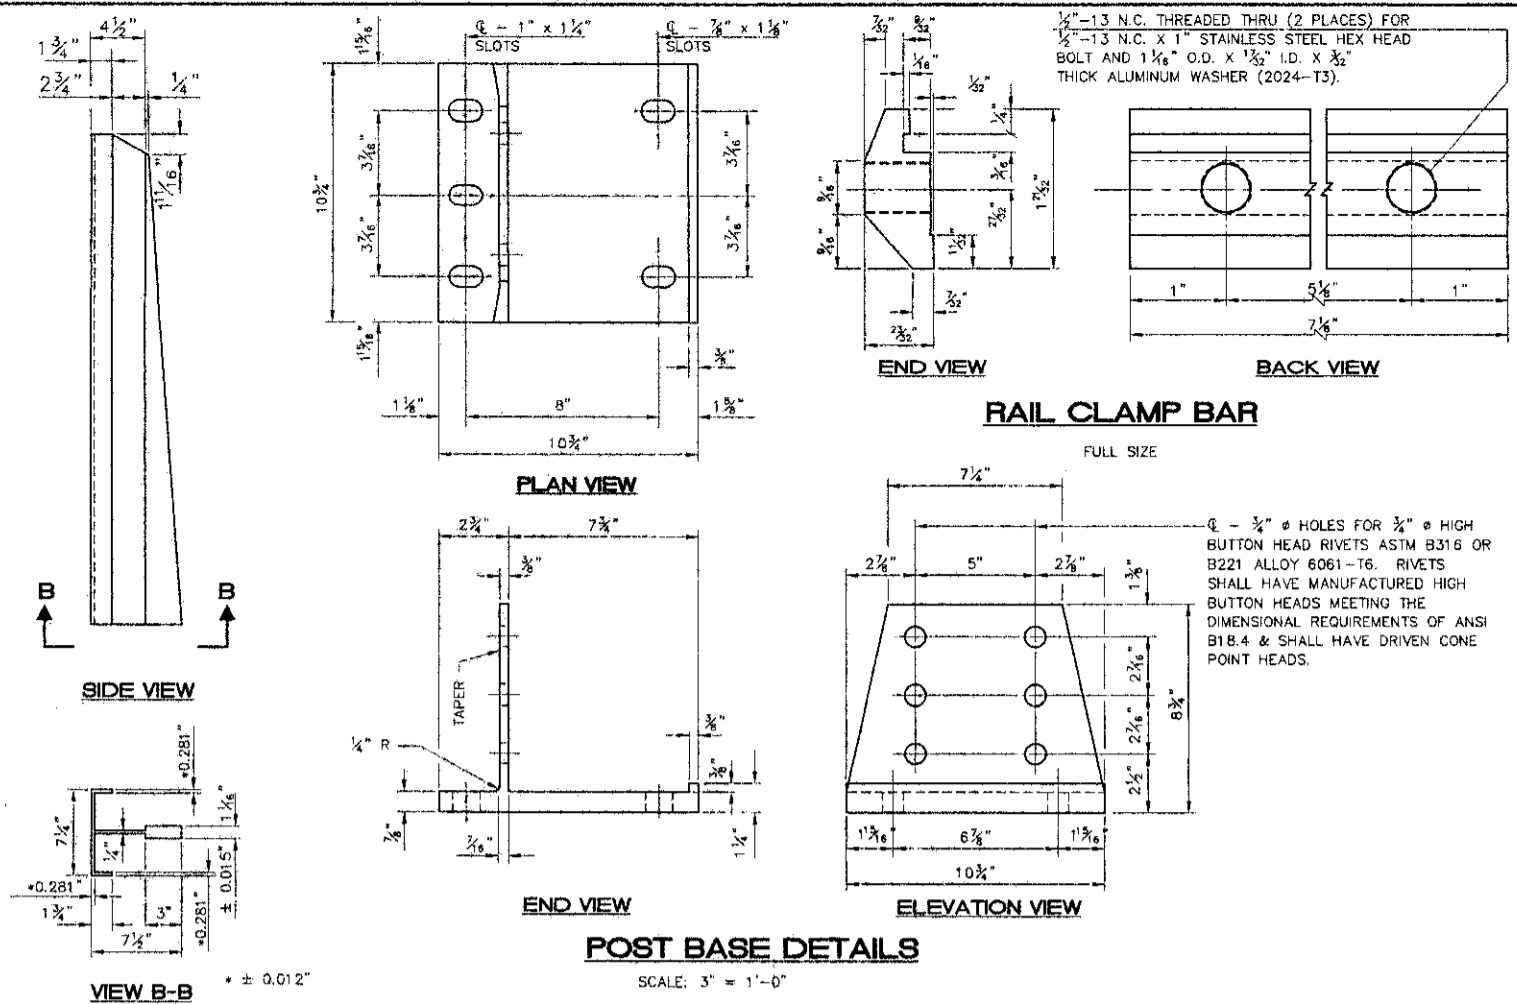

**RAIL NOTES:**

1. POSTS SHALL BE NORMAL TO FINISHED GRADE.
2. THREADS FOR ANCHOR BOLTS MAY BE ROLLED OR CUT. IF CUT THREADS ARE USED BOLT DIAMETER SHALL NOT BE LESS THAN NOMINAL DIAMETER. IF ROLLED THREADS ARE USED, BOLT DIAMETER SHALL NOT BE LESS THAN ROOT DIAMETER OF THREADS.
3. JOINTS IN RAIL LENGTH SHALL BE SPLICED AS DETAILED.
4. ENDS OF TUBE SECTIONS SHALL BE SAWED OR MILLED.
5. CUT ENDS SHALL BE TRUE AND SMOOTH.
6. EACH RAIL SECTION SHALL BE ATTACHED TO A MINIMUM OF FOUR (4) POSTS.
7. GRIND ALL EDGES SMOOTH.

**MATERIAL:**

1. ALUMINUM EXTRUSIONS (POSTS, BASES, RAILS, SPLICE BARS, PINS AND CLAMP BARS) SHALL BE ASTM B221, ALLOY 6061-T6 OR ALLOY 6351-T5 (MIN. 10% ELONGATION).
2. STAINLESS STEEL ANCHOR STUDS, HEX HEAD BOLTS AND HEX NUTS (TYPE 302) SHALL BE ASTM A276, (TYPE 430 MOD) OR (TYPE 304 MOD), (100,000 PSI AND 15% ELONGATION).
3. STEEL EMBEDDED JAM AND HEX NUTS SHALL BE ASTM A563 GRADE A OR BETTER.
4. ALUMINUM WASHERS SHALL BE ASTM B209, ALLOY 2024-T3 ALCLAD.
5. PREFORMED ELASTOMERIC BEARING PAD SHALL MEET REQUIREMENTS OF AASHTO M251.



**ANCHOR ASSEMBLY NOTES:**

1. 3/8" x 3/8" AMERICAN STANDARD FINISHED HEXAGON STEEL NUTS ON BOTTOM OF ANCHOR ASSEMBLY, 3/4" x 3/4" AMERICAN STANDARD FINISHED HEXAGON STEEL JAM NUTS ON TOP OF ANCHORAGE PLATE.
2. 3/4" x 3/4" STAINLESS STEEL HEXAGON NUTS ON TOP ENDS OF BOLTS WITH CLASS 2B THREADS, 1 1/2" I.D., 1 1/2" O.D., 1/8" THICK ALUMINUM WASHERS UNDER NUTS ON TOP. ALL NUTS SHALL COMPLY WITH AMERICAN HEXAGON ANSI SPEC. B18.2. STAINLESS STEEL HEXAGON NUTS SHALL HAVE FULL THREADS.

**SPLICE BAR DETAILS:**

1. SEE SHEET 18 FOR SPLICE BAR DETAILS AND NOTES.

AS-BUILT (OCTOBER 31, 1998)





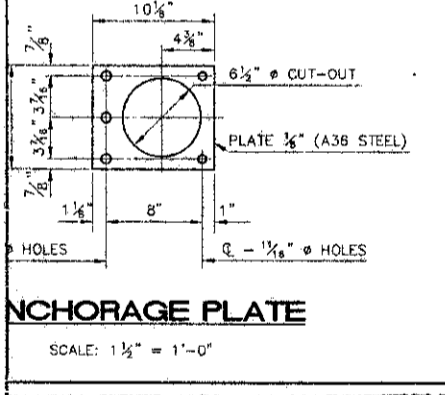
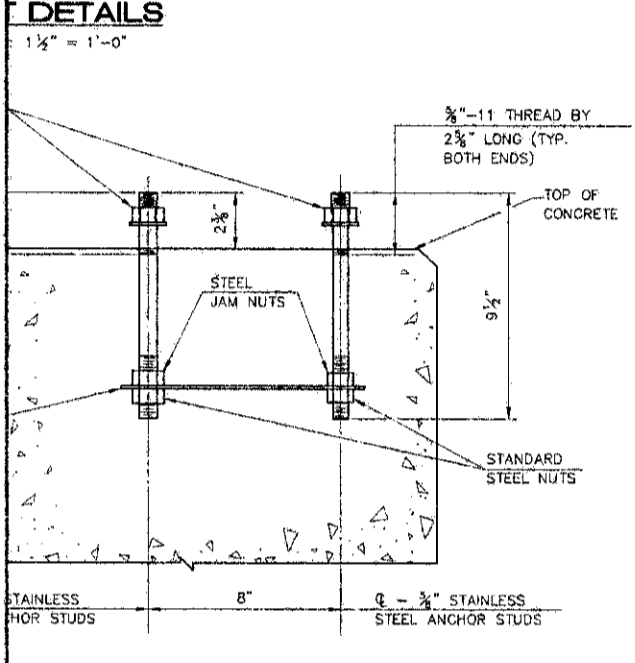


STATE OF NEW HAMPSHIRE			
DEPARTMENT OF TRANSPORTATION • BUREAU OF BRIDGE DESIGN			
<b>BRIDGE RAIL DETAILS (3-BAR ALUMINUM)</b>			
TOWN <u>FREMONT</u>		BRIDGE NO. <u>096/095</u>	
LOCATION <u>SANDOWN ROAD BRIDGE OVER EXETER RIVER</u>			
DESIGNED	NHDOT	DATE	FILE NUMBER
DRAWN	KJT/GMC	9/87	93-2-1
TRACED	TJM	8/97	BRIDGE SHEET NO.
QUANTITIES		CHECKED	OF
FEDERAL PROJECT NO.		STATE PROJECT NO.	SHEET NO.
		12544	16
		TOTAL SHEETS	24

REVISION	DESCRIPTION	BY	DATE

BACKKilam Project No. 96071.00 BACKKilam CAD File BR-3BAR.DWG

**BAC Killam**  
1000 North Street, Suite 200  
Exeter, New Hampshire 03833  
603-251-1100 • Fax 603-251-1104

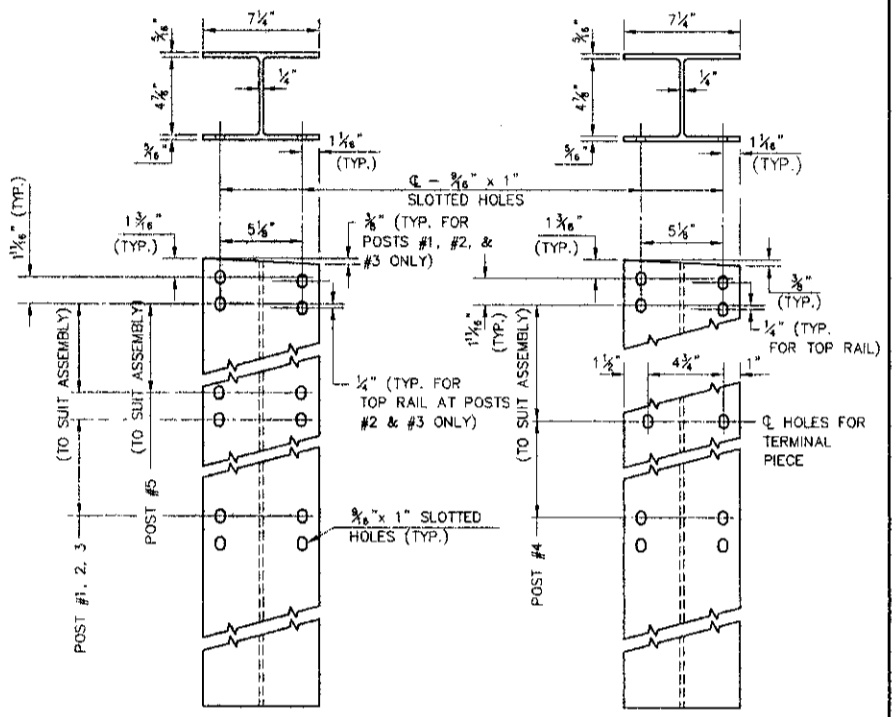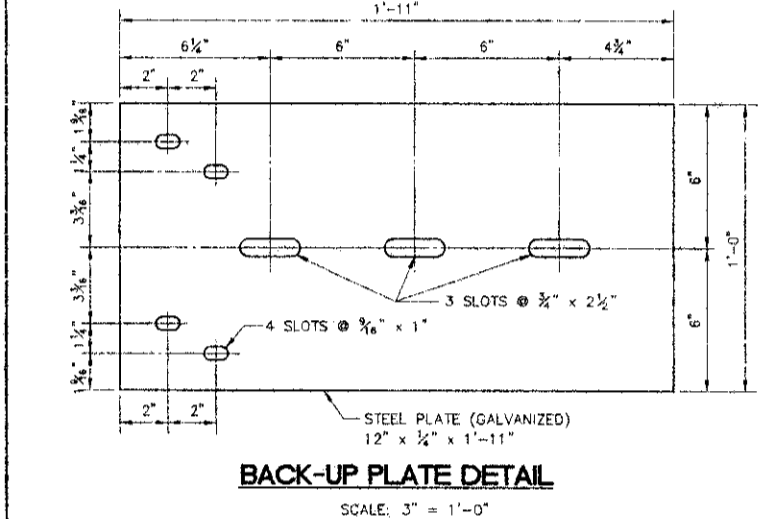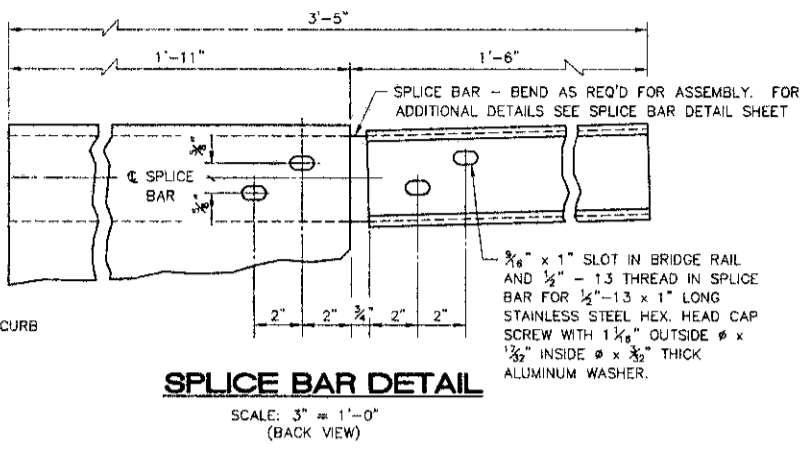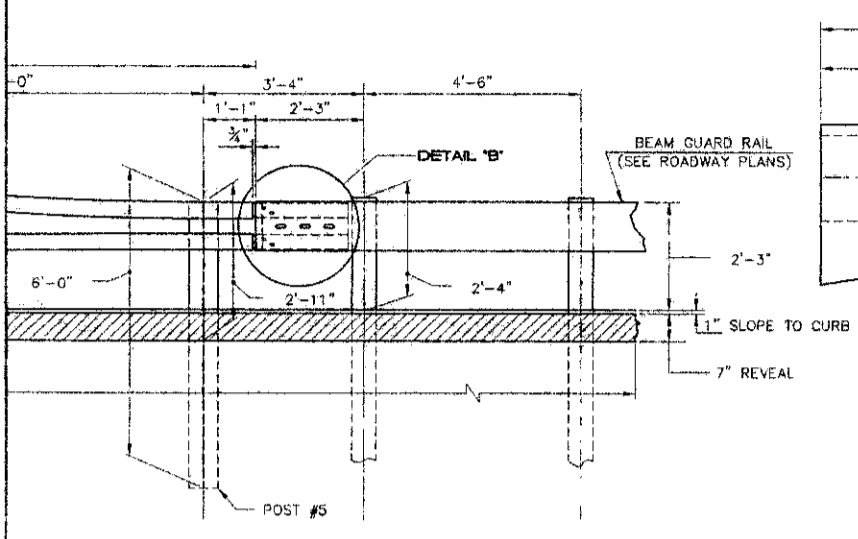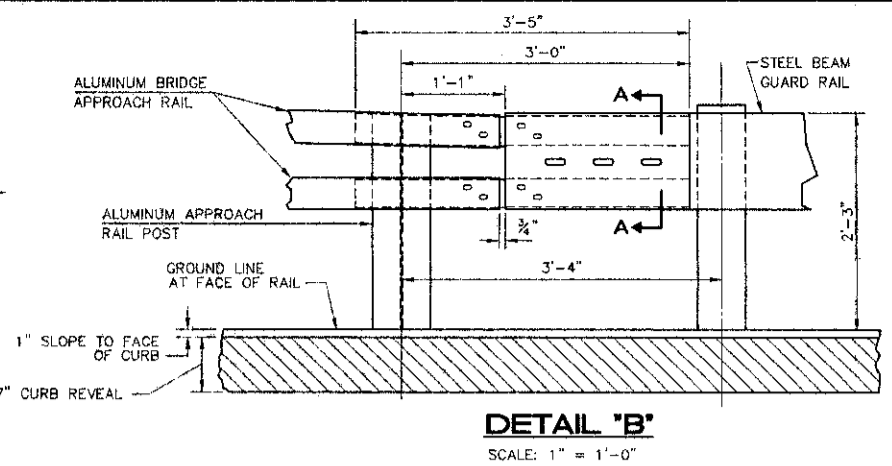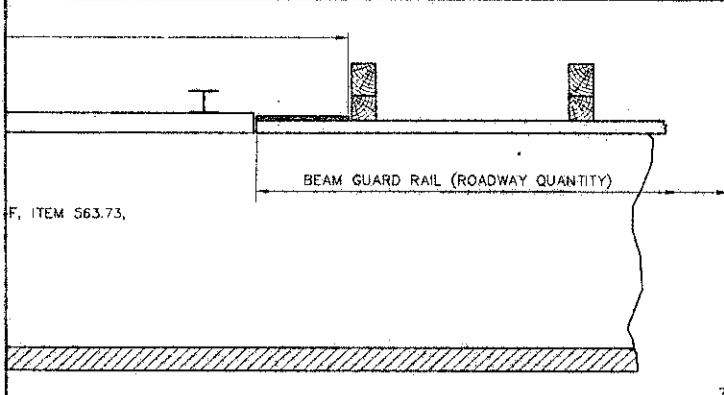

TING BOLT, NUT, & WASHER ON BEAM GUARD RAIL SHEET (QUANTITY)

METRICAL ABOUT Q.


UP PLATE (GALVANIZED) (QUANTITY)

ON OF STEEL BEAM (ROADWAY QUANTITY)

P SCREW, SEE SPLICE (BRIDGE QUANTITY)

BEND AS REQ'D FOR ASSEMBLY. (ALL DETAILS SEE SPLICE BAR DETAIL SHEET)

DRILL & TAP FOR HEAD CAP SCREW (TYP) (QUANTITY)

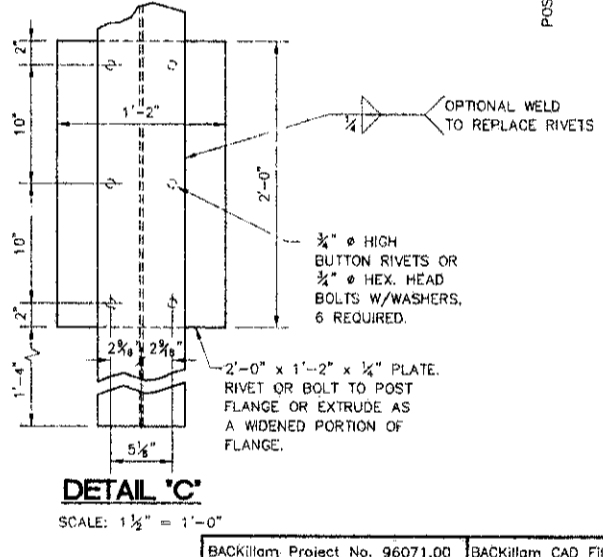


AS-BUILT (OCTOBER 31, 1998)

STATE OF NEW HAMPSHIRE			
DEPARTMENT OF TRANSPORTATION • BUREAU OF BRIDGE DESIGN			
<b>APPROACH RAIL DETAILS (3-BAR ALUMINUM)</b>			
TOWN	FREMONT	BRIDGE NO.	096/095
LOCATION SANDOWN ROAD BRIDGE OVER EXETER RIVER			
DESIGNED	NHDDOT	CHECKED	BY DATE FILE NUMBER
DRAWN	PJP	2/91	MWR 7/91 93-2-1
TRACED	TJM	8/97	MAS 8/97
QUANTITIES		CHECKED	BRIDGE SHEET NO.
			OF
FEDERAL PROJECT NO.	STATE PROJECT NO.	SHEET NO.	TOTAL SHEETS
	12544	17	24

BACKillam Project No. 96071.00 BACKillam CAD File APP-3BAR.DWG


**BAC Killam**  
1800 West 27th Street  
Portland, ME 04106  
Tel: 603-763-7000 Fax: 603-763-7004



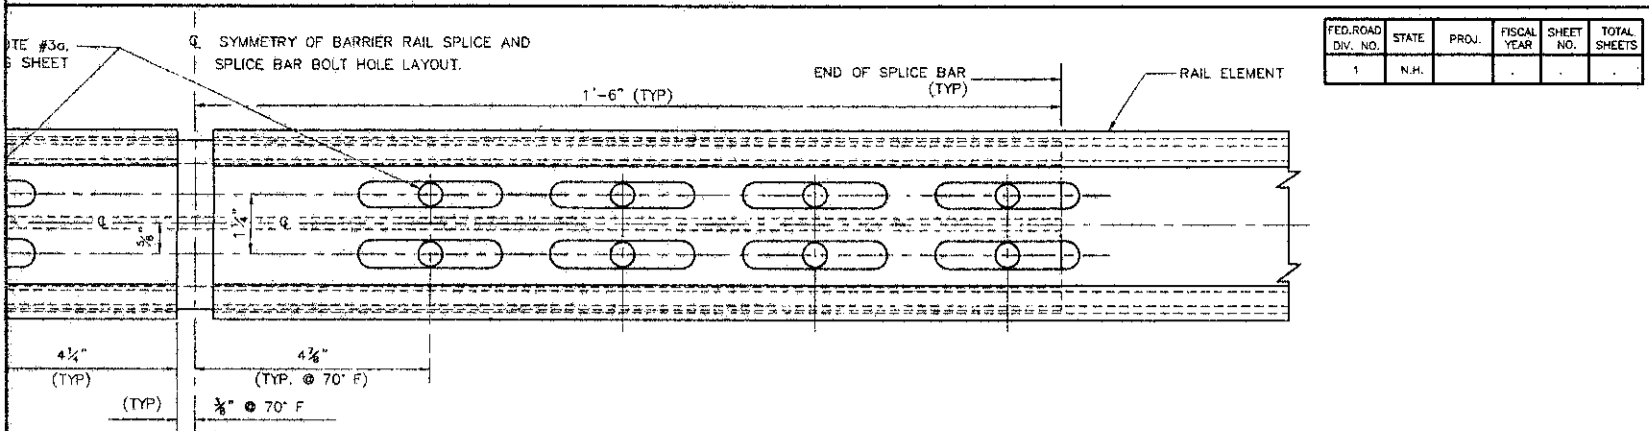


FED. ROAD DIV. NO.	STATE	PROJ.	FISCAL YEAR	SHEET NO.	TOTAL SHEETS
1	N.H.				


**STANDARD SPLICE ASSEMBLY DETAILS**

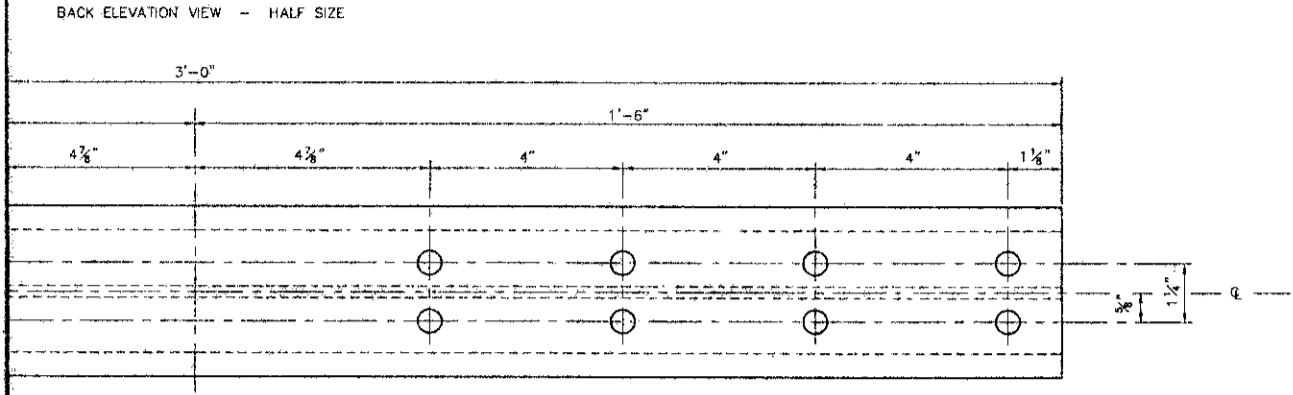

**SPLICE BAR FOR BRIDGE RAIL**

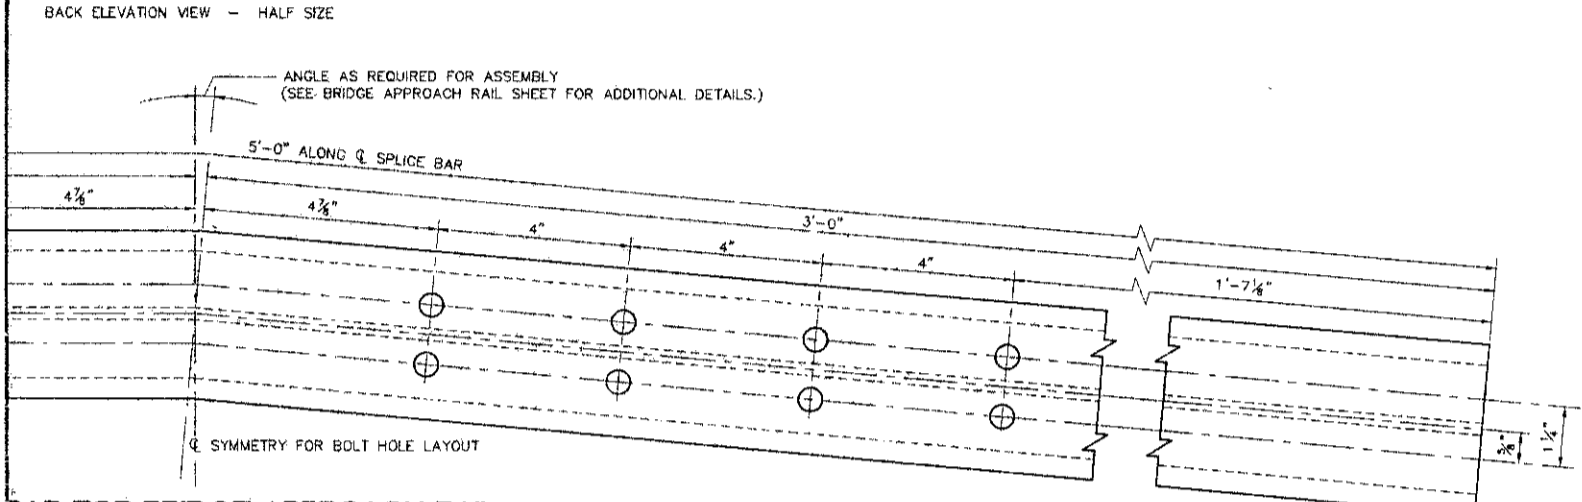


**SPLICE BAR FOR BRIDGE APPROACH RAIL**

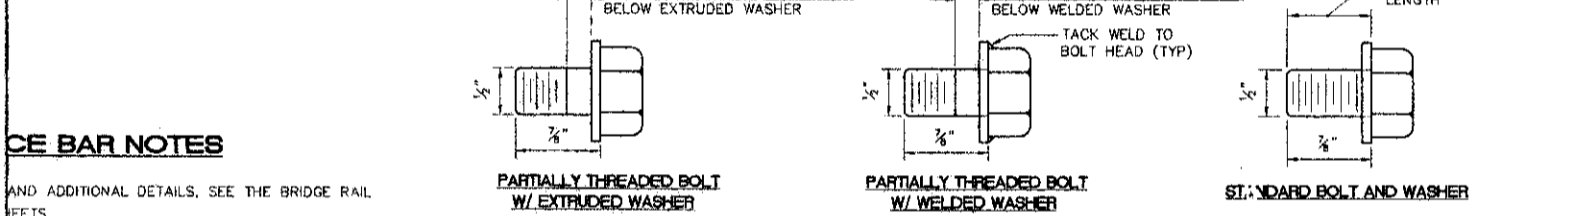

**SPLICE BAR NOTES**

AND ADDITIONAL DETAILS, SEE THE BRIDGE RAIL SHEETS.  
 APPROACH RAILS SHALL HAVE SLOTTED HOLES AT THE END.

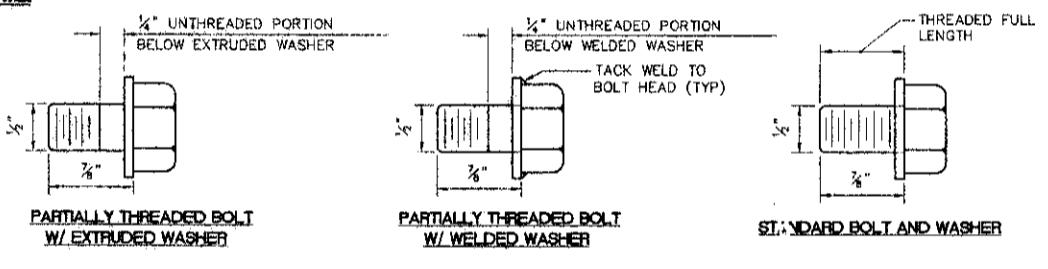

**SPLICE BAR BOLT DETAILS AS-BUILT (OCTOBER 31, 1998)**


FASTENED TO THE RAIL ELEMENT AS FOLLOWS:  
 BOTH BRIDGE AND APPROACH RAILS SHALL BE FASTENED ON BOTH SIDES WITH BOLTS & WASHERS TIGHTENED SECURELY. THE OTHER SIDE OF THE JOINT SHALL BE FASTENED USING THE PARTIALLY THREADED BOLTS WITH EITHER THE EXTRUDED WASHER, TIGHTENED SECURELY TO THE END OF THE THREADS, THIS ALLOWS EXPANSION ON ONE SIDE OF THE JOINT. BRIDGE EXPANSION JOINT SHALL BE FASTENED ON BOTH SIDES USING THE PARTIALLY THREADED BOLTS, WITH EITHER THE WELDED WASHER, TIGHTENED SECURELY TO THE END OF THE THREADS, THIS ALLOWS EXPANSION ON BOTH SIDES OF THE JOINT. THIS ALLOWS EXPANSION ON BOTH SIDES OF THE JOINT.

REVISION	DESCRIPTION	BY	DATE
1	AS-BUILT		


STATE OF NEW HAMPSHIRE			
DEPARTMENT OF TRANSPORTATION • BUREAU OF BRIDGE DESIGN			
<b>BRIDGE RAIL SPLICE BAR DETAILS (ALUMINUM)</b>			
TOWN <u>FREMONT</u>		BRIDGE NO. <u>096/095</u>	
LOCATION <u>SANDOWN ROAD BRIDGE OVER EXETER RIVER</u>			
DESIGNED <u>NHDDT</u>	DATE <u></u>	CHECKED <u></u>	DATE <u></u>
DRAWN <u>MWR</u>	DATE <u>8/88</u>	CHECKED <u>MWR</u>	DATE <u>1/90</u>
TRACED <u>TJM</u>	DATE <u>8/97</u>	CHECKED <u>MAS</u>	DATE <u>8/97</u>
QUANTITIES		CHECKED	
FEDERAL PROJECT NO.	STATE PROJECT NO. <u>12544</u>	SHEET NO. <u>18</u>	TOTAL SHEETS <u>24</u>

BACKkilam Project No. 96071.00  
 BACKkilam CAD File SPL-BAR.DWG  
 BAC Kilam  
 1000 North Main Street  
 Concord, NH 03301  
 Phone: 603-271-2000  
 Fax: 603-271-2000

FED. ROAD DIV. NO.	STATE	PROJ.	FISCAL YEAR	SHEET NO.	TOTAL SHEETS
1	N.H.				

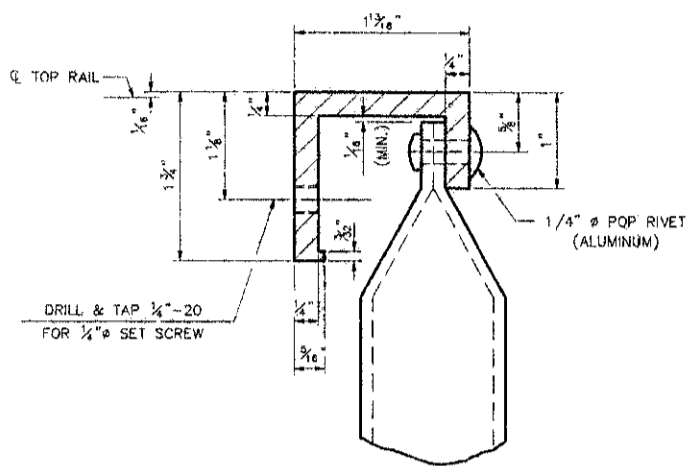

**DETAIL 'A'**  
FULL SIZE

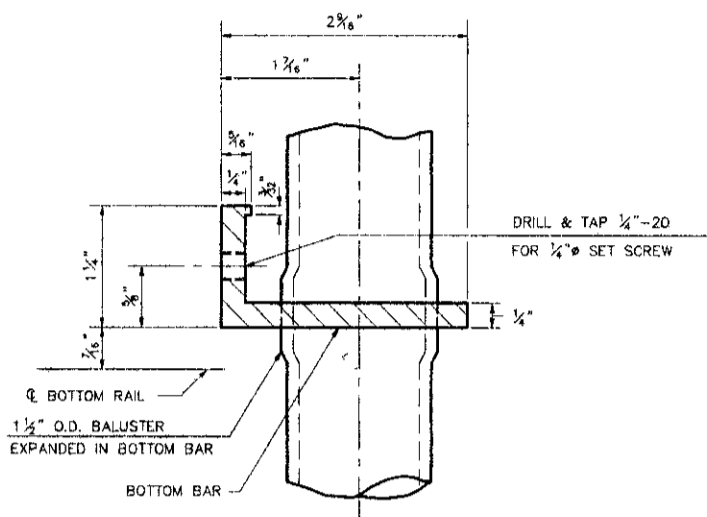

**DETAIL 'B'**  
FULL SIZE

3'-0 1/2" LONG.  
WALL BALUSTERS  
POST

**BALUSTER NOTES**

1. BALUSTERS AND ATTACHMENTS SHALL BE PAID FOR UNDER ITEM 563.73.
2. ALUMINUM BALUSTERS AND ATTACHMENTS SHALL CONFORM TO THE REQUIREMENTS SPECIFIED IN N.H. SPECIFICATION 563.2.6.
3. PAY LIMITS FOR BALUSTERS SHALL BE AS SHOWN ON THE PLANS.

AS-BUILT (OCTOBER 31, 1998)



STATE OF NEW HAMPSHIRE			
DEPARTMENT OF TRANSPORTATION • BUREAU OF BRIDGE DESIGN			
<b>ALUMINUM BALUSTER DETAILS</b>			
TOWN <u>FREMONT</u>		BRIDGE NO. <u>096/095</u>	
LOCATION <u>SANDOWN ROAD BRIDGE OVER EXETER RIVER</u>			
DESIGNED <u>NHDOT</u>	DATE	CHECKED <u>MWR</u>	DATE
DRAWN <u>GMC/CADD</u>	<u>9/87</u>	CHECKED <u>MAS</u>	<u>1/90</u>
TRACED <u>TJM</u>	<u>8/97</u>	CHECKED	
QUANTITIES		CHECKED	
FEDERAL PROJECT NO.		STATE PROJECT NO. <u>12544</u>	SHEET NO. <u>19</u>
			TOTAL SHEETS <u>24</u>

REVISION DESCRIPTION	BY	DATE

BACKILLIAM Project No. 86071.00 BACKILLIAM CAD File BALUSTER.DWG

**BAC Killiam**  
1000 North Main Street • Suite 200  
Manchester, New Hampshire 03101-2000  
Tel: 603-251-1000 • Fax: 603-251-1001

FILE NUMBER  
93-2-1  
BRIDGE SHEET NO.  
OF

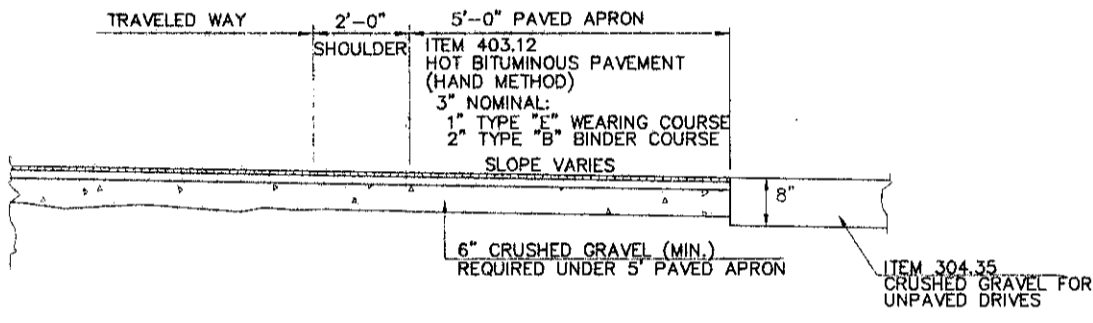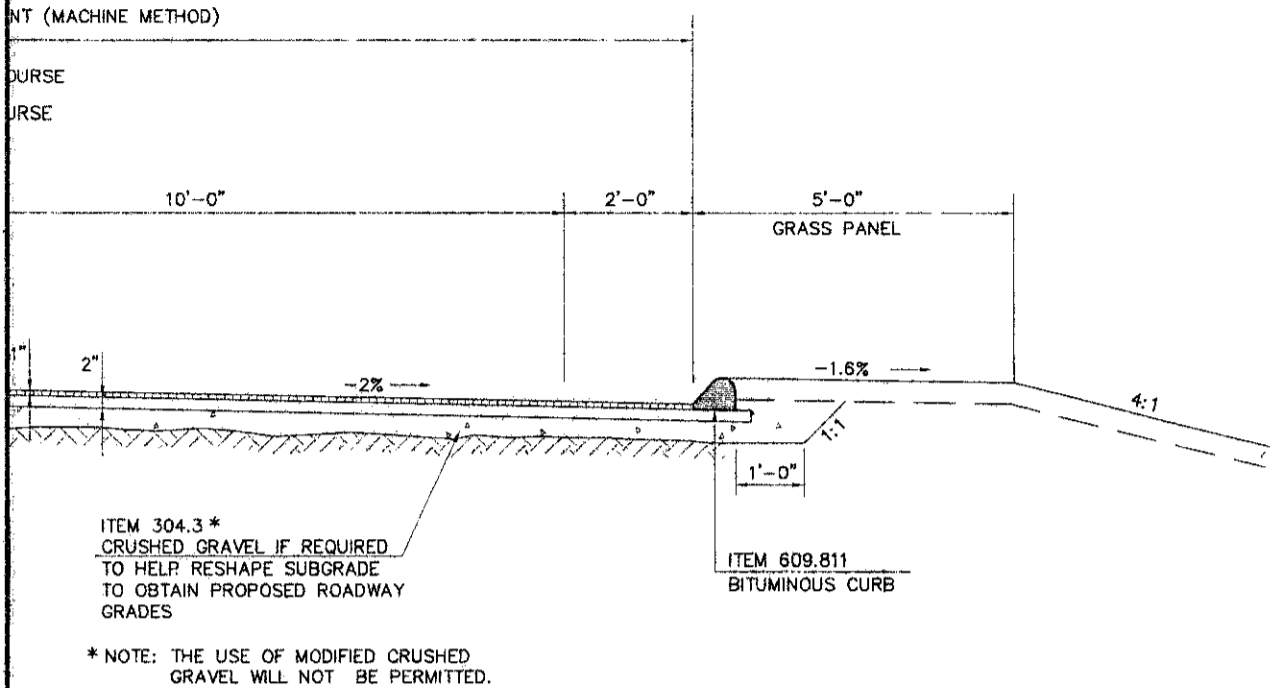


**DRIVE TYPICAL  
FOR UNPAVED DRIVES**

\* SEE CROSS-SECTIONS FOR EACH DRIVE LOCATION

AS-BUILT (OCTOBER 31, 1998)

**ROADWAY TYPICAL SECTION**

		<b>BAC Kilom</b> <small>THE CONCORD CENTER          10 FERRY STREET          CONCORD, NH 03301</small>		SCALE 1" = 3'	
BAC PROJECT NO.	BAC CAD FILENAME	FEDERAL PROJECT NO.	STATE PROJECT NO.	SHEET NO.	TOTAL SHEETS
96071.00	TYPICAL.DWG		12544	20	24

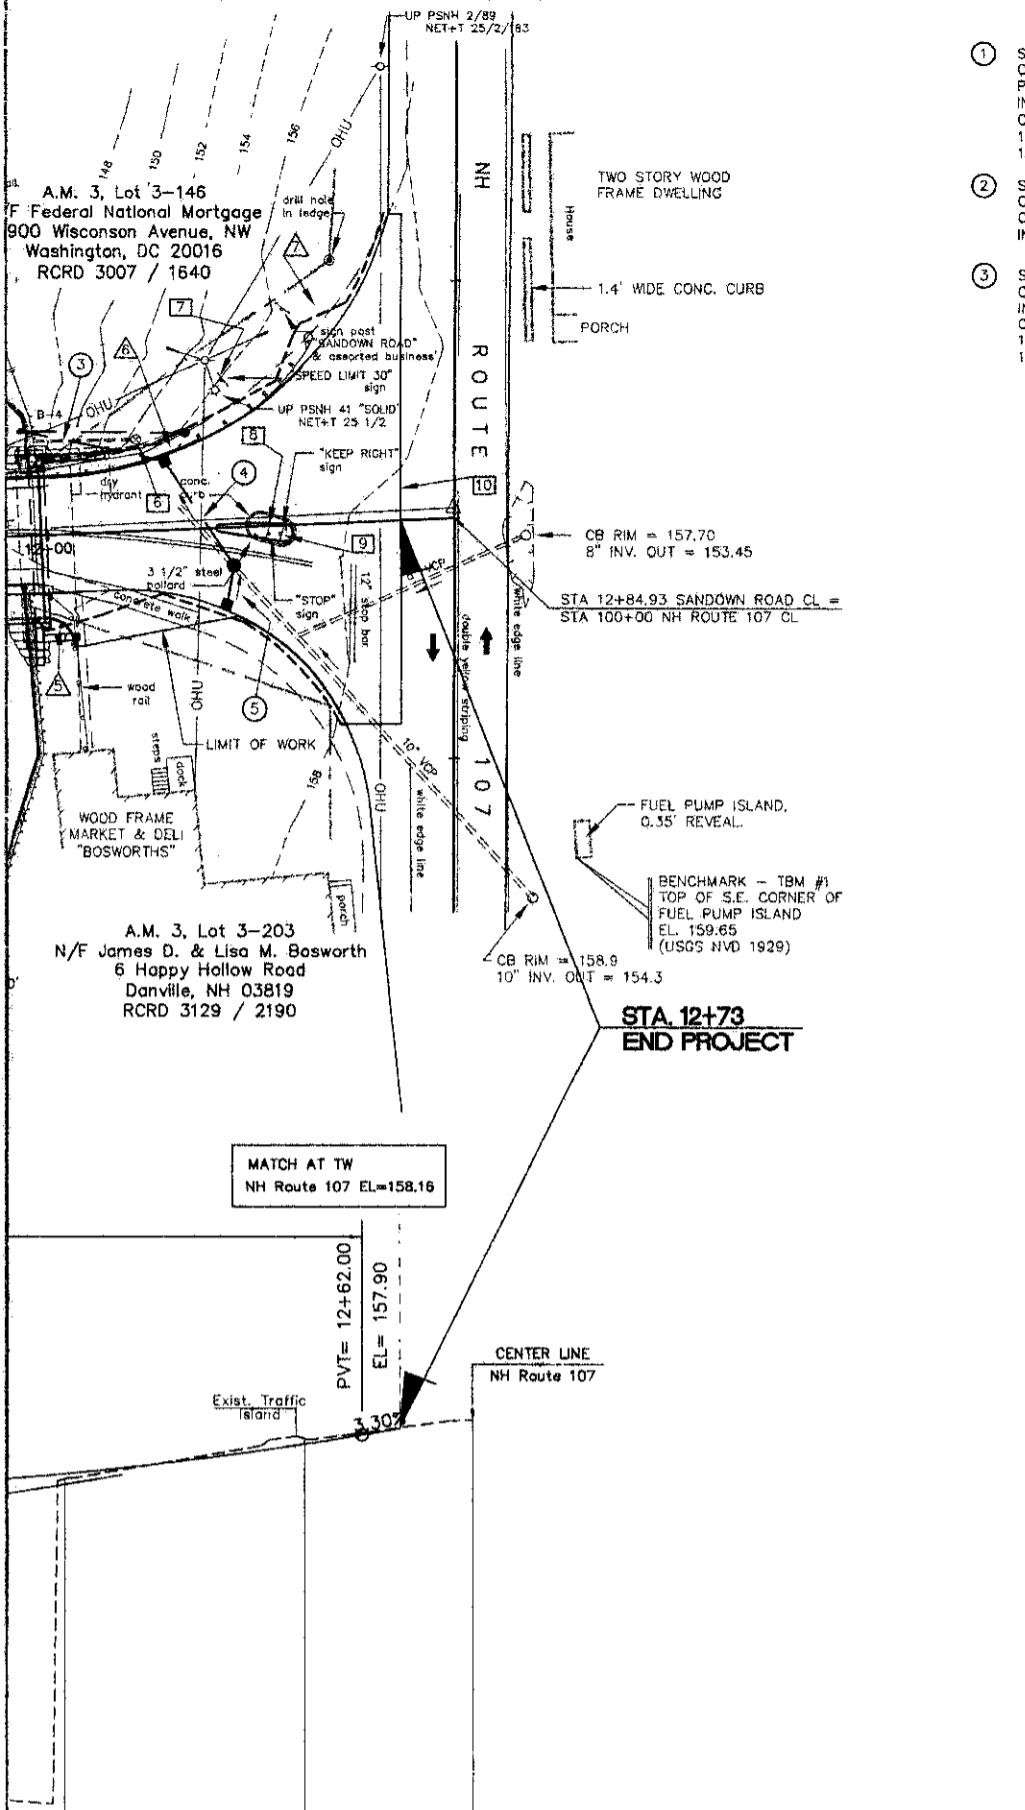

**DRAINAGE NOTES**

- ① STA 11+21 TO STA 11+45  
CONST. 35 LF x 15" RCP, 2000D  
PLACE EXCAVATED ROCK (ITEM 586.2)  
INV. @ OUTLET = 150.00  
CONST. CB-B, ALT. 1, +21, RT 11'  
15" INV. OUT = 150.75  
15" INV. IN = 151.00
- ② STA 11+21 TO STA 11+21  
CONST. 22 LF x 15" RCP, 2000D  
CONST. CB-B, ALT. 1, +21, LT 12'  
INV. OUT = 151.25
- ③ STA 11+97 TO STA 12+25  
CONST. 28 LF x 15" RCP, 2000D  
INV. @ OUTLET = 145.9  
CONST. CB-B, ALT. 1, +25, LT 14'  
15" INV. OUT = 147.90  
15" INV. IN = 152.25
- ④ STA 12+25 TO STA 12+39  
CONST. 26 LF x 15" RCP, 2000D  
CONST. DMH, +39, RT 8'  
15" INV. OUT = 152.55  
10" INV. IN = 153.2±  
15" INV. IN = 152.65
- ⑤ STA 12+38 TO STA 12+37  
CONST. 8 LF x 15" RCP, 2000D  
CONST. CB-B, ALT. 1, +37, RT 16'  
15" INV. OUT = 152.75
- ⑥ PLACING EXCAVATED ROCK FOR CHANNEL PROTECTION (ITEM 586.2)

**GUARDRAIL NOTES**

- △ STA 10+80 TO STA 11+17, RT  
REMOVE STUMPS (SUBSID.)  
CONST. BEAM GUARDRAIL  
TERMINAL UNIT TYPE MELT  
(ITEM 606.1451)
- △ STA 11+17 TO STA 11+51, RT  
REMOVE STUMPS (SUBSID.)  
CONST. BRIDGE APPROACH  
RAIL F (ITEM 565.73)
- △ STA 11+13 TO STA 11+18, LT  
CONST. BEAM GUARDRAIL  
TERMINAL UNIT TYPE G-2  
(ITEM 606.147)
- △ STA 11+18 TO STA 11+51, LT  
CONST. BRIDGE APPROACH  
RAIL F (ITEM 565.73)
- △ STA 11+99 TO STA 12+05, RT  
CONST. BRIDGE APPROACH  
RAIL F (ITEM 565.73)
- △ STA 11+33 TO STA 12+58, LT  
CONST. BRIDGE APPROACH  
RAIL (ITEM 565.73)
- △ STA 12+33 TO STA 12+58, LT  
CONST. BEAM GUARDRAIL  
TERMINAL UNIT TYPE MELT  
(ITEM 606.1451)

**NOTES**

- ① STA 10+00  
SAW CUT BITUMINOUS PVMT.  
(ITEM 628.2)
- ② STA 10+50, RT  
CONST. PAVED DRIVEWAY APRON  
AND GRAVEL DRIVE
- ③ STA 10+75, RT  
REMOVE MAILBOX & ASSEMBLIES  
CONST. MAILBOX & ASSEMBLIES  
2 REQUIRED (ITEM 670.066)
- ④ STA 10+80  
UTILITY POLE TO BE  
RELOCATED BY OTHERS
- ⑤ STA 11+10, LT  
CONST. PAVED DRIVEWAY APRON  
AND GRAVEL DRIVE
- ⑥ STA 12+25, LT  
EXIST. DRY HYDRANT TO REMAIN  
RESET HEIGHT AS REQUIRED (ITEM 1002.)
- ⑦ STA 12+38, LT  
REMOVE AND STACK  
EXIST. TRAFFIC SIGN,  
TYPE C (SUBSID.)
- ⑧ STA 12+46, RT  
REMOVE AND STACK  
EXIST. TRAFFIC SIGN,  
TYPE C (SUBSID.)
- ⑨ STA 12+49, RT  
REMOVE AND STACK  
EXIST. TRAFFIC SIGN,  
TYPE C (SUBSID.)
- ⑩ STA 12+73  
SAW CUT BITUMINOUS PVMT.  
(ITEM 628.2)

AS-BUILT (OCTOBER 31, 1998)

**ROADWAY PLAN AND PROFILE**


TOWN <b>FREMONT</b>		BRIDGE NO. <b>096/095</b>	
LOCATION <b>SANDOWN ROAD BRIDGE OVER EXETER RIVER</b>			
DESIGNED <b>MAS</b>	DATE <b>4/97</b>	CHECKED <b>DCK</b>	DATE <b>8/97</b>
DRAWN <b>SLM</b>	DATE <b>8/97</b>	CHECKED <b>MAS</b>	DATE <b>8/97</b>
QUANTITIES		CHECKED	
REVISION DESCRIPTION		BY	DATE
BAC&C Project No. 96071.00		BAC&C CAD File ROADPLN.DWG	
 <b>BAC Kilam</b> <small>THE CONCORD CENTER 10 TERRY STREET CONCORD, NH 03301</small>			
STATE FILE NO.	STATE PROJECT NO.	SHEET NO.	TOTAL SHEETS
<b>93-2-1</b>	<b>12544</b>	<b>21</b>	<b>24</b>

A.M. 3, Lot 3-146  
Federal National Mortgage  
900 Wisconsin Avenue, NW  
Washington, DC 20016  
RCRD 3007 / 1640


A.M. 3, Lot 3-203  
N/F James D. & Lisa M. Bosworth  
6 Happy Hollow Road  
Danville, NH 03819  
RCRD 3129 / 2190

156.1	156.30
157.7	157.52

12+00	12+62.00	157.90
-------	----------	--------

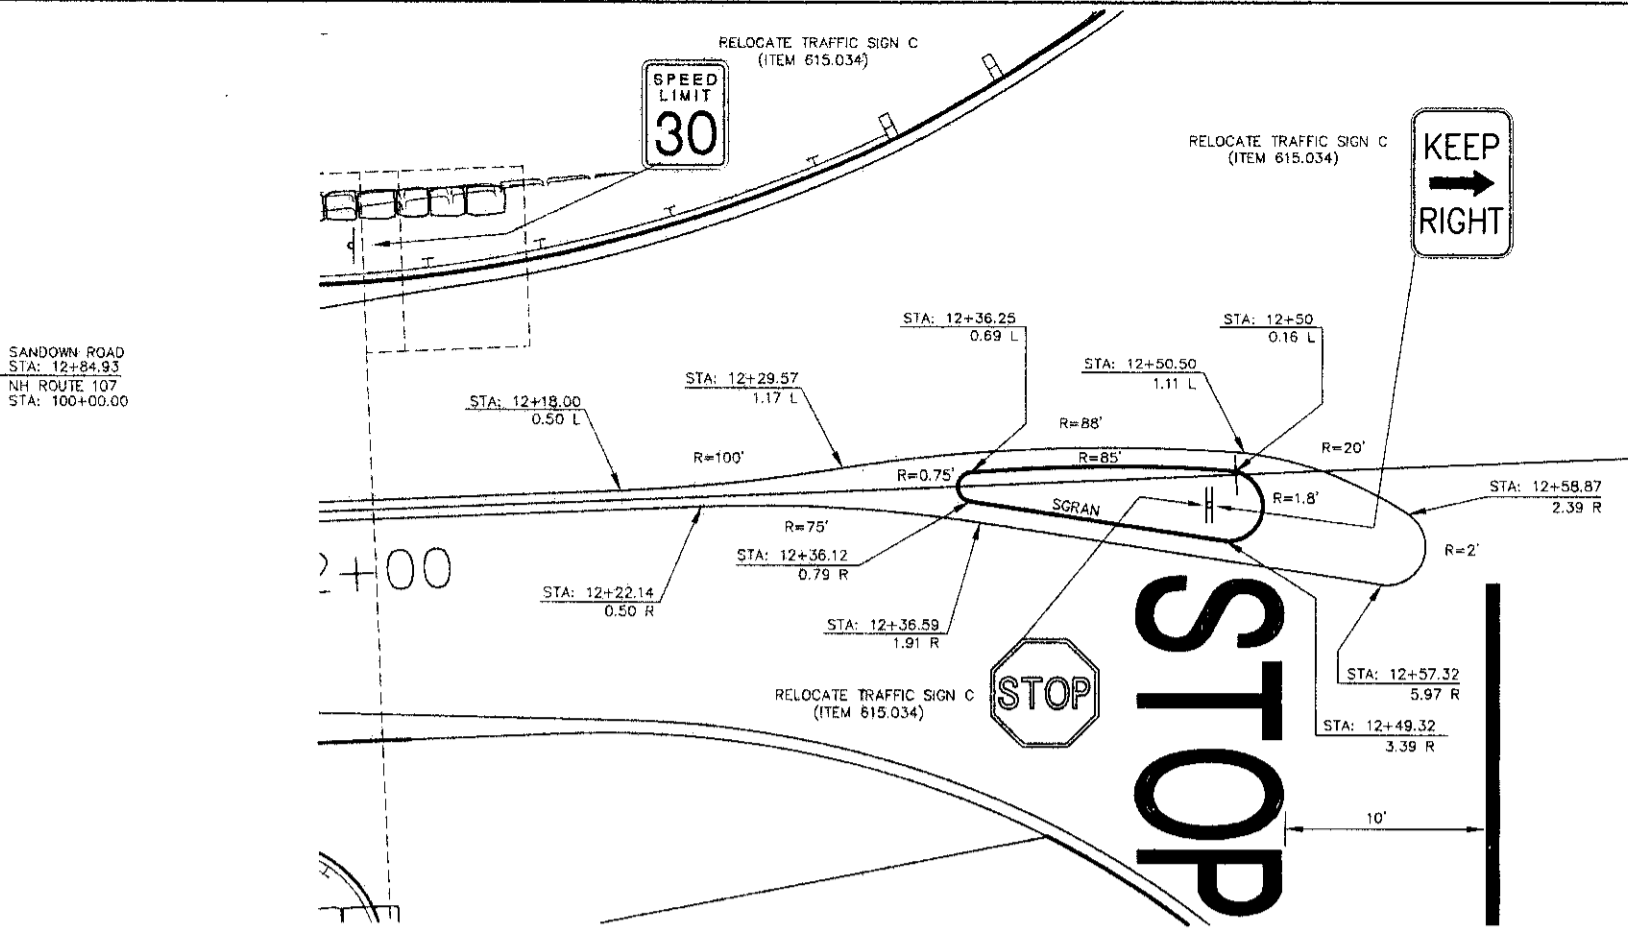


**BLOWUP 'A'**  
SCALE: 1" = 5'

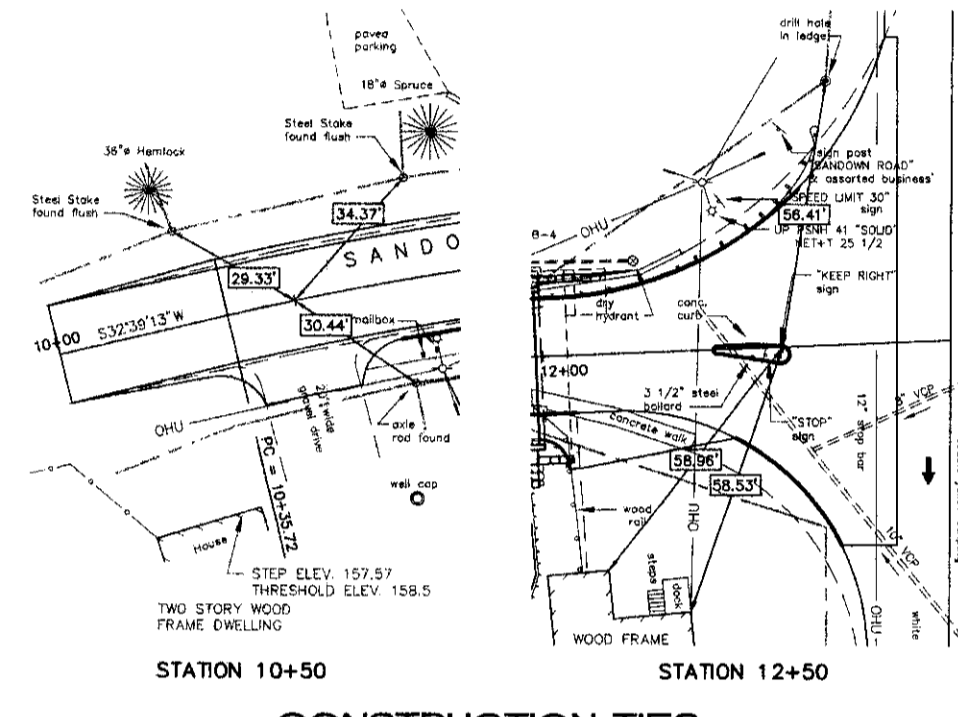

**CONSTRUCTION TIES**  
SCALE: 1" = 20'

AS-BUILT (OCTOBER 31, 1998)

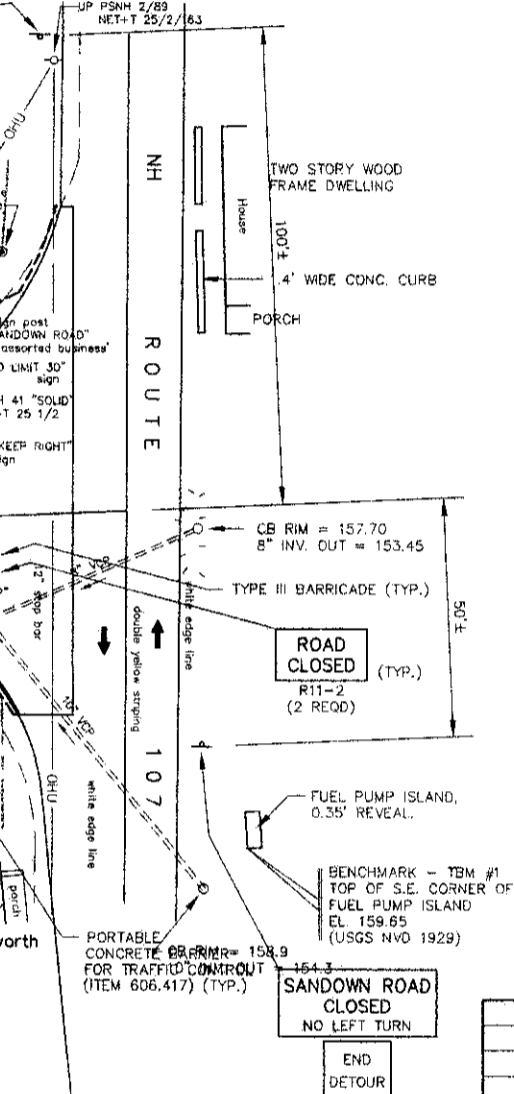


**CURBING, PAVEMENT, AND PAINTING LAYOUT ROAD CLOSURE / CONSTRUCTION TIES**

TOWN <u>FREMONT</u>		BRIDGE NO. <u>096/095</u>				
LOCATION <u>SANDOWN ROAD BRIDGE OVER EXETER RIVER</u>						
DESIGNED	MAS	4/97	CHECKED	MAS	8/97	FILE NUMBER
DRAWN	SLM	8/97	CHECKED	MAS	8/97	BRIDGE SHEET NO.
QUANTITIES			CHECKED			OF
STATE FILE NO.		STATE PROJECT NO.		SHEET NO.	TOTAL SHEETS	
<u>93-2-1</u>		<u>12544</u>		<u>22</u>	<u>24</u>	


REVISION	DESCRIPTION	BY	DATE

BA&C Project No. 96071.00 BA&C CAD File PVMTPLAN.DWG

**BAC Kilam**  
10 FOUNTAIN STREET  
CONCORD, NH 03301

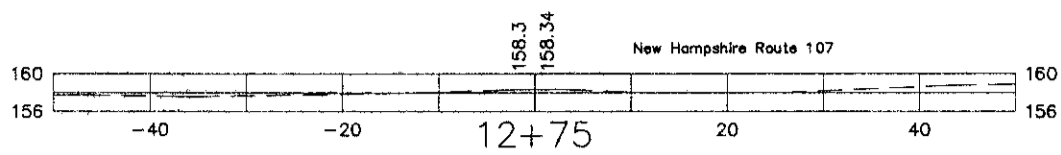


STA. 12+73  
END PROJECT  
(MATCH EXISTING)

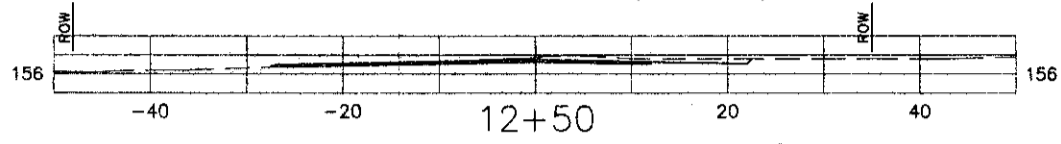


③ STA 12+33 TO STA 12+58, LT  
CONST. BEAM GUARDRAIL  
TERMINAL UNIT TYPE MELT  
(ITEM 606.1451)

④ STA 12+25 TO STA 12+45  
CONST. 25 LF x 15" RCP, 20000  
CONST. DMH, +45, RT 7.5'  
15" INV. OUT = 152.55  
10" INV. IN = 153.2±  
15" INV. IN = 152.65

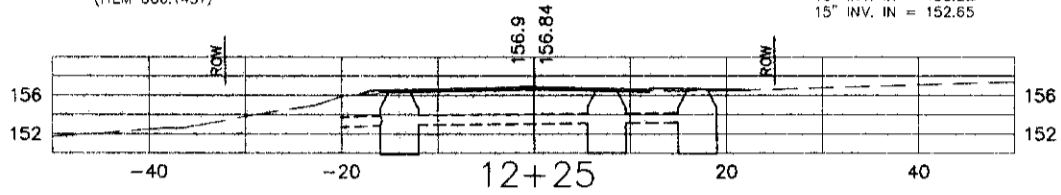


③ STA 11+97 TO STA 12+25  
CONST. 38 LF x 15" RCP, 20000  
INV. @ OUTLET = 145.9  
CONST. CB-B, ALT. 1, +25, LT 14'  
15" INV. OUT = 147.90  
15" INV. IN = 152.25

⑤ STA 12+25 TO STA 12+45  
CONST. 7 LF x 15" RCP, 20000  
CONST. CB-B, ALT. 1, +40, RT 17'  
15" INV. OUT = 152.75

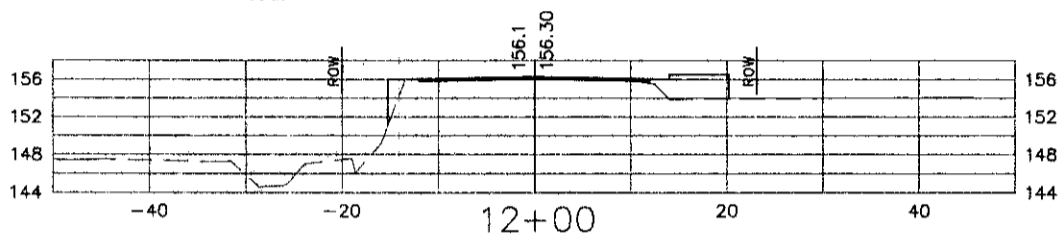

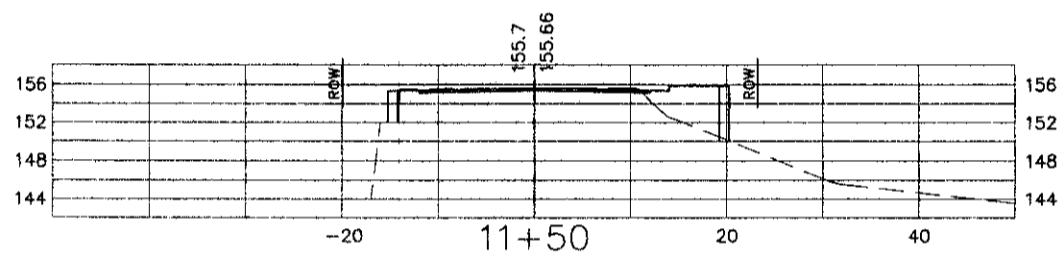

⑤ STA 11+99 TO STA 12+05, RT  
CONST. BRIDGE APPROACH  
RAIL F (ITEM 565.73)



⑤ STA 11+33 TO STA 12+58, LT  
CONST. BRIDGE APPROACH  
RAIL. (ITEM 565.73)

AS-BUILT (OCTOBER 31, 1998)

CROSS-SECTIONS  
SANDOWN ROAD


BA&C Project No. 96071.00	BA&C CAD File XSEC.DWG	 <b>BAC Kilam</b> THE CONCORD CENTER 10 FERRY STREET CONCORD, NH 03301	FILE NUMBER							
 <b>BAC Kilam</b> THE CONCORD CENTER 10 FERRY STREET CONCORD, NH 03301			<table border="1"> <tr> <td>FEDERAL PROJECT NO.</td> <td>STATE PROJECT NO.</td> <td>SHEET NO.</td> <td>TOTAL SHEETS</td> </tr> <tr> <td>97-2-1</td> <td>12544</td> <td>23</td> <td>24</td> </tr> </table>	FEDERAL PROJECT NO.	STATE PROJECT NO.	SHEET NO.	TOTAL SHEETS	97-2-1	12544	23
FEDERAL PROJECT NO.	STATE PROJECT NO.	SHEET NO.	TOTAL SHEETS							
97-2-1	12544	23	24							

**GENERAL NOTES:**


- 1.) NO LAYOUT OF SANDOWN ROAD WAS FOUND IN THE TOWN RECORDS OF FREEMONT, NH.
- 2.) WETLANDS IDENTIFICATION AND FLAGGING SHOWN HEREON IS AS DETERMINED BY NEW HAMPSHIRE SOIL CONSULTANTS, INC. ON SEPTEMBER 17, 1996.
- 3.) VERTICAL DATUM OF THE ELEVATIONS AND TOPOGRAPHY SHOWN HEREON IS THE UNITED STATES GEOLOGICAL SURVEY NATIONAL VERTICAL DATUM OF 1929. SAID DATUM USED WAS BROUGHT TO THIS SITE FROM USGS VERTICAL CONTROL DISC "R-1931, RESET 1963" LOCATED ON THE NORTHERLY SIDE OF ROUTE 107 APPROXIMATELY 0.6 MILE EAST OF THIS SITE.
- 4.) CONTOUR INTERVAL SHOWN IS 2 FEET.
- 5.) WETLAND IMPACTS:  
 TEMPORARY WETLAND IMPACTS = 699 sf  
 PERMANENT WETLAND IMPACTS = 831 sf  
 TOTAL WETLAND IMPACTS = 1530 sf

**REFERENCE PLANS:**

- 1.) "PLAT OF LAND FOR JOSEPH F. FAVALARO AND JANIE E. TURKEWICH IN FREEMONT N.H.," SCALE: 1" = 50'; DATED: JUNE 1981; BY: PARKER SURVEY ASSOCIATES, INC.; R.C.R.D. PLAN C10218.
- 2.) "PLAN OF LAND FOR JESSE AND MEREDITH BOLOUC IN FREEMONT, N.H.," SCALE: 1" = 50'; DATED: 8 JULY 1983; BY: SEACOAST ENGINEERING ASSOCIATES, INC.; R.C.R.D. PLAN C-12588.

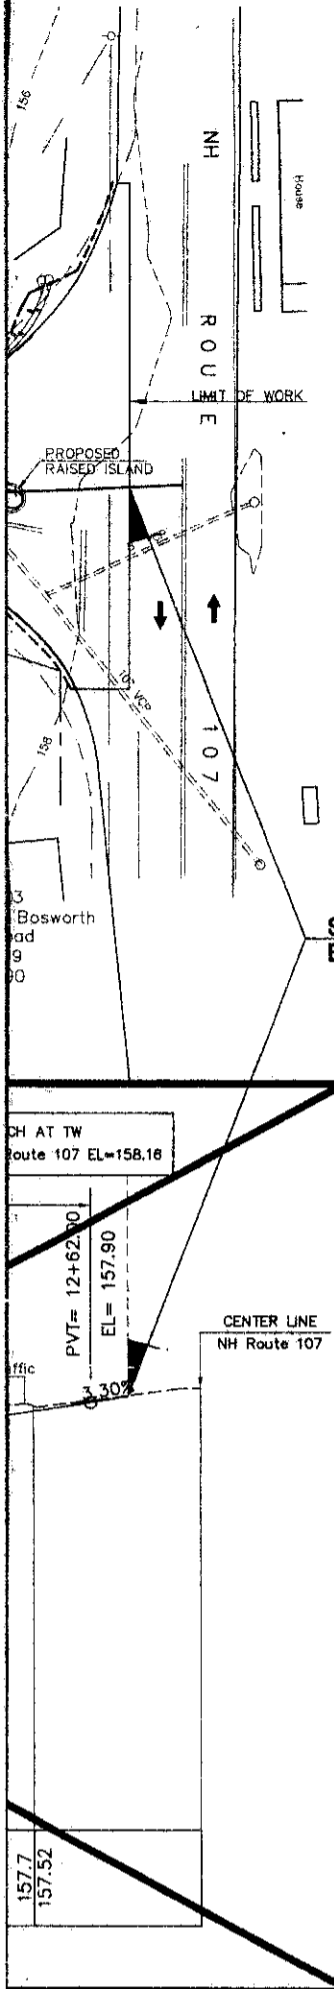

STA. 12+73  
END PROJECT

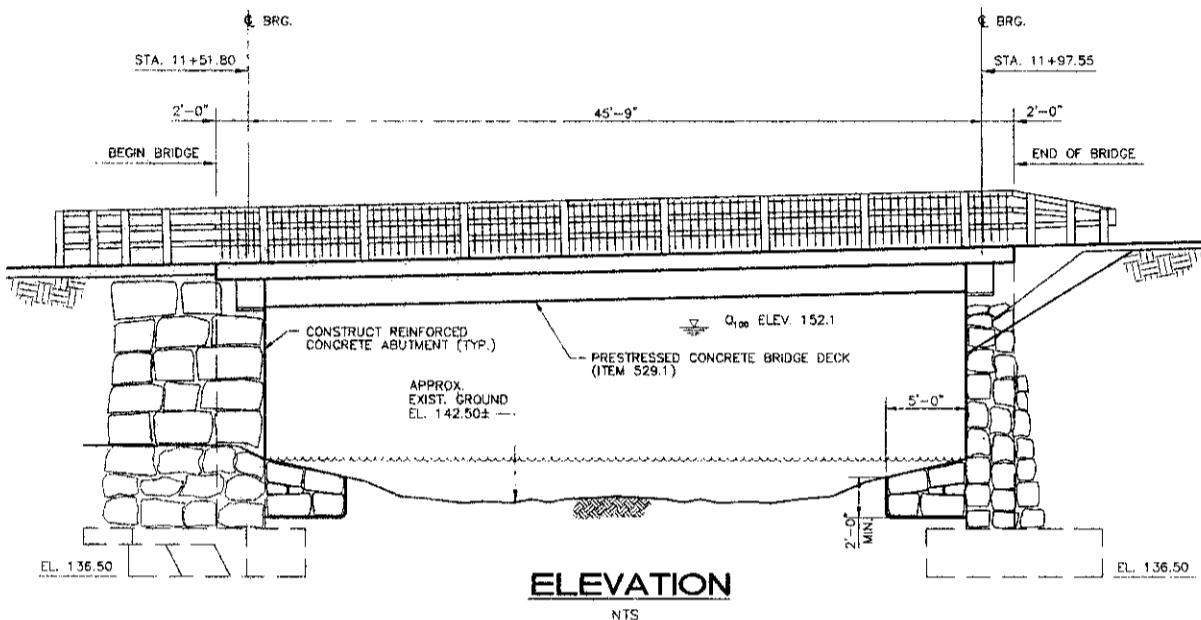

**ELEVATION**

NTS

AS-BUILT (OCTOBER 31, 1998)

FOR INFORMATION ONLY

**WETLAND PERMIT PLAN  
FOR SANDOWN RD. BRIDGE**

TOWN		FREMONT		BRIDGE NO.		096/095	
LOCATION		SANDOWN ROAD BRIDGE OVER EXETER RIVER					
DESIGNED	MAS	4/97	CHECKED	MAS	5/97	FILE NUMBER	
DRAWN	MTB	4/97	CHECKED	MAS	5/97	BRIDGE SHEET NO.	
QUANTITIES			CHECKED			OF	
REVISION DESCRIPTION		BY	DATE				
BA&C Project No. 96071.00		BA&C CAD File		WET.DWG			
 <b>BAC Kilom</b> THE CONCORD CENTER 10 FERRY STREET CONCORD, NH 03301							
STATE FILE NO.		STATE PROJECT NO.		SHEET NO.		TOTAL SHEETS	
93-2-1		12544		24		24	

RPA/APP TOWN BR

# Voting Sheets



HOUSE COMMITTEE ON RESOURCES, RECREATION AND DEVELOPMENT

EXECUTIVE SESSION on HJR 1

**BILL TITLE:** directing the department of transportation and the department of environmental services to study the prevention of further erosion of the east bank of the Exeter River.

**DATE:** February 8, 2011

**LOB ROOM:** 305

**Amendments:**

Sponsor: Rep. OLS Document #:

Sponsor: Rep. OLS Document #:

Sponsor: Rep. OLS Document #:

**Motions:** OTP, OTP/A, ITD, Interim Study (Please circle one.)

Moved by Rep. Pettengill

Seconded by Rep. Merrow

Vote: 15-0 (Please attach record of roll call vote.)

**Motions:** OTP, OTP/A, ITL, Interim Study (Please circle one.)

Moved by Rep.

Seconded by Rep.

Vote: (Please attach record of roll call vote.)

**CONSENT CALENDAR VOTE: 15-0**

(Vote to place on Consent Calendar must be unanimous.)

**Statement of Intent:** Refer to Committee Report

Respectfully submitted,

Rep. Chris Christensen, Clerk

HOUSE COMMITTEE ON RESOURCES, RECREATION AND DEVELOPMENT

EXECUTIVE SESSION on HJR 1

**BILL TITLE:** directing the department of transportation and the department of environmental services to study the prevention of further erosion of the east bank of the Exeter River.

**DATE:** 2/8/11

**LOB ROOM:** 305

Amendments:

Sponsor: Rep.	OLS Document #:
Sponsor: Rep.	OLS Document #:
Sponsor: Rep.	OLS Document #:

Motions: OTP, OTP/A, ITL, Interim Study (Please circle one.)

Moved by Rep. *Patterson*

Seconded by Rep. *McCrack*

Vote: *15/0* (Please attach record of roll call vote.)

Motions: OTP, OTP/A, ITL, Interim Study (Please circle one.)

Moved by Rep.

Seconded by Rep.

Vote: (Please attach record of roll call vote.)

CONSENT CALENDAR VOTE:

(Vote to place on Consent Calendar must be unanimous.) *Yes*

Statement of Intent: Refer to Committee Report

Respectfully submitted,

Rep. Chris Christensen, Clerk

*David Russell acting clerk*

**RESOURCES, RECREATION AND DEVELOPMENT**

Bill #: HJR 1 Title: directing DOT & DES to study prevention

PH Date: 2/1/11 of further erosion on Exeter River Exec Session Date: 2/8/11

Motion: ITL Amendment #: \_\_\_\_\_

MEMBER	YEAS	NAYS
Renzullo, Andrew, Chairman	✓	
Kappler, Lawrence M, V Chairman	✓	
Christensen, D.L. Chris		
Russell, David H	✓	
Ahlgren, Christopher J	✓	
Merrow, Harry C	✓	
Bolster, Peter S	✓	
Howard, Thomas J		
Hutchinson, Winfred O	✓	
Lovett, Charlene M	✓	
Pettengill, Laurie P	✓	
Schroadter, Adam R	✓	
Spang, Judith T	✓	
Parkhurst, Henry A. L.	✓	
Moody, Marcia G	✓	
Aguiar, James D	✓	
Thomas, Yvonne D	✓	
TOTAL VOTE:	15	0

# Committee Report

**CONSENT CALENDAR**

**February 10, 2011**

**HOUSE OF REPRESENTATIVES**

**REPORT OF COMMITTEE**

The Committee on RESOURCES, RECREATION AND DEVELOPMENT to which was referred HJR1,

AN ACT directing the department of transportation and the department of environmental services to study the prevention of further erosion of the east bank of the Exeter River. Having considered the same, report the same with the following Resolution: **RESOLVED**, That it is **INEXPEDIENT TO LEGISLATE**.

**Rep. Laurie P Pettengill**

**FOR THE COMMITTEE**

## COMMITTEE REPORT

Committee:	<b>RESOURCES, RECREATION AND DEVELOPMENT</b>
Bill Number:	<b>HJR1</b>
Title:	<b>directing the department of transportation and the department of environmental services to study the prevention of further erosion of the east bank of the Exeter River.</b>
Date:	<b>February 10, 2011</b>
Consent Calendar:	<b>YES</b>
Recommendation:	<b>INEXPEDIENT TO LEGISLATE</b>

### STATEMENT OF INTENT

This resolution would direct the Department of Transportation (DOT) and the Department of Environmental Services (DES) to study the prevention of further erosion of the east bank of the Exeter River. The sponsor alleges that a bridge built ten years ago by the town in conjunction with the DOT, shifted the erosion from one bank of the river to the other bank, causing damage to the property of a local business. The sponsor feels the engineering design was faulty. The DOT maintains that the town is the primary entity constructing the bridge and that the engineer was hired and supervised by the town. The committee heard testimony from DES that there are many factors that could contribute to bank erosion, including the flooding of recent years. Conspicuously absent was testimony from the town and from the property owner. This resolution is really asking the committee to adjudicate a liability dispute. We are not equipped to do that and thus cannot grant what the resolution requests. It should be noted, however, that DES did volunteer to meet with town officials should they request it.

Vote 15-0.

Rep. Laurie P Pettengill  
FOR THE COMMITTEE

Original: House Clerk  
Cc: Committee Bill File

## CONSENT CALENDAR

### RESOURCES, RECREATION AND DEVELOPMENT

**HJR1**, directing the department of transportation and the department of environmental services to study the prevention of further erosion of the east bank of the Exeter River. **INEXPEDIENT TO LEGISLATE.**

Rep. Laurie P Pettengill for RESOURCES, RECREATION AND DEVELOPMENT. This resolution would direct the Department of Transportation (DOT) and the Department of Environmental Services (DES) to study the prevention of further erosion of the east bank of the Exeter River. The sponsor alleges that a bridge built ten years ago by the town in conjunction with the DOT, shifted the erosion from one bank of the river to the other bank, causing damage to the property of a local business. The sponsor feels the engineering design was faulty. The DOT maintains that the town is the primary entity constructing the bridge and that the engineer was hired and supervised by the town. The committee heard testimony from DES that there are many factors that could contribute to bank erosion, including the flooding of recent years. Conspicuously absent was testimony from the town and from the property owner. This resolution is really asking the committee to adjudicate a liability dispute. We are not equipped to do that and thus cannot grant what the resolution requests. It should be noted, however, that DES did volunteer to meet with town officials should they request it. **Vote 15-0.**


Original: House Clerk  
Cc: Committee Bill File

HJR 1

ITL

This resolution would direct the Department of Transportation (DOT) and the Department of Environmental Services (DES) to study the prevention of further erosion of the east bank of the Exeter River. The sponsor alleges that a bridge built ten years ago by the town in conjunction with the DOT, shifted the erosion from one bank of the river to the other bank, causing damage to the property of a local business. The sponsor feels the engineering design was faulty. The DOT maintains that the town is the primary entity constructing the bridge and that the engineer was hired and supervised by the town. The committee heard testimony from DES that there are many factors that could contribute to bank erosion, including the flooding of recent years. Conspicuously absent was testimony from the town and from the property owner. This resolution is really asking the committee to adjudicate a liability dispute. We are not equipped to do that and thus cannot grant what the resolution requests. It should be noted, however, that DES did volunteer to meet with town officials should they request it.

Laurie Pettengill

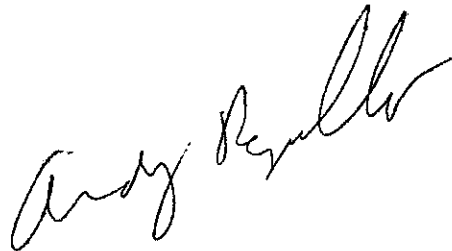A handwritten signature in cursive script, appearing to read "Andy Revullo". The signature is written in dark ink and is positioned in the lower right quadrant of the page.